


T. 4S. R. 3W. WM.

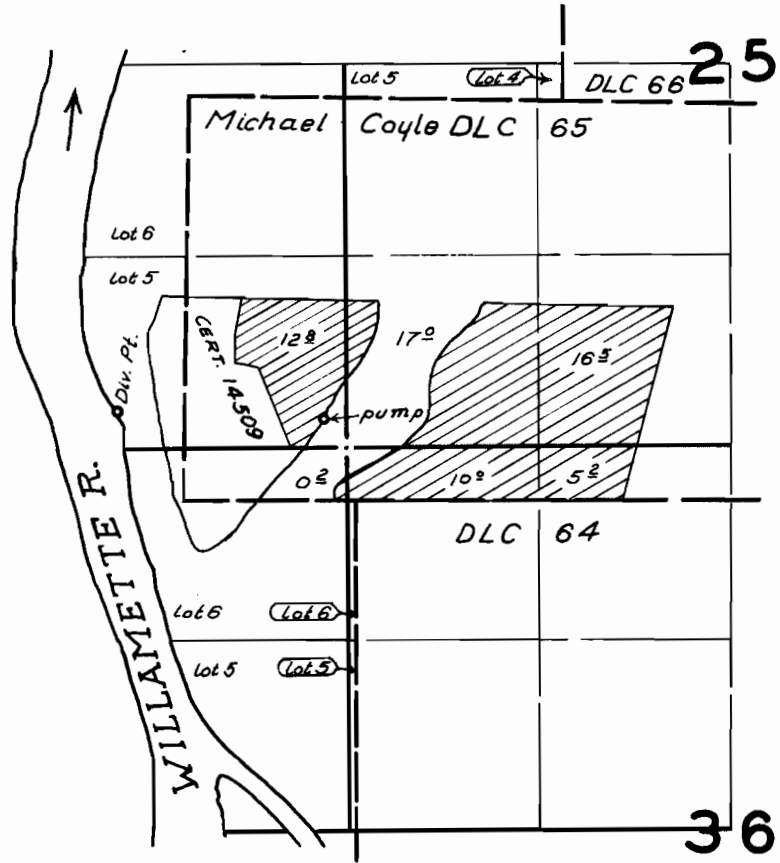

**FINAL PROOF SURVEY**  
UNDER

Application No. 30327 ... Permit No. 23737 ...  
IN NAME OF

C. V. Smidt

Surveyed April 24 1959, by R. H. Jackson