


T.21 S.R.46E.W.M.

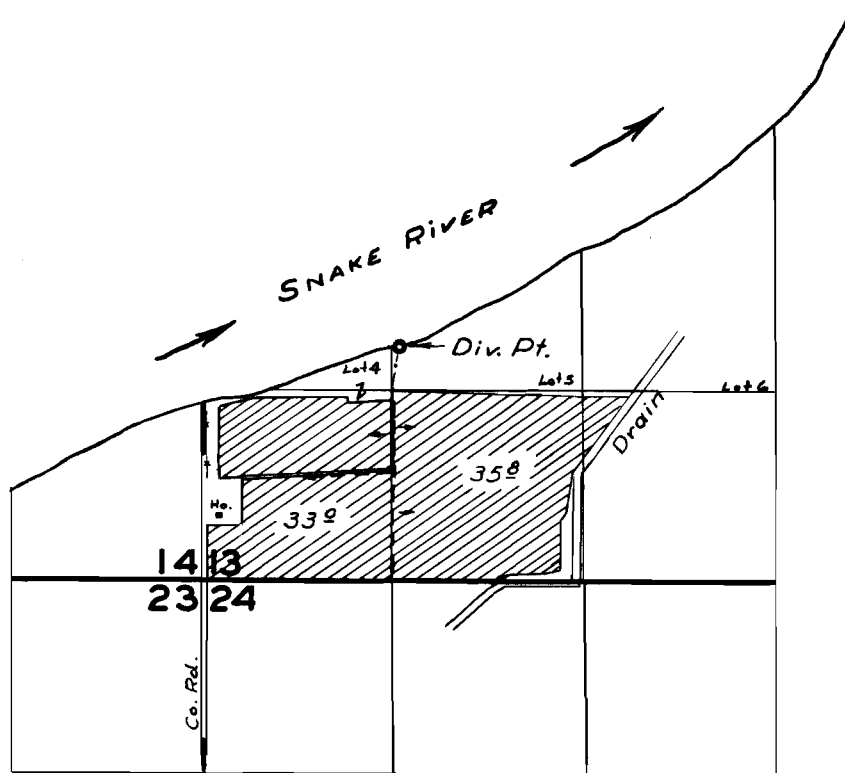

FINAL PROOF SURVEY
UNDER

Application No. 30421 Permit No. 23897
IN NAME OF

WALTER BISHOP

Surveyed 16 Sept. 1959, by Tr. Bishop