


T.10S. R.23E.W.M.

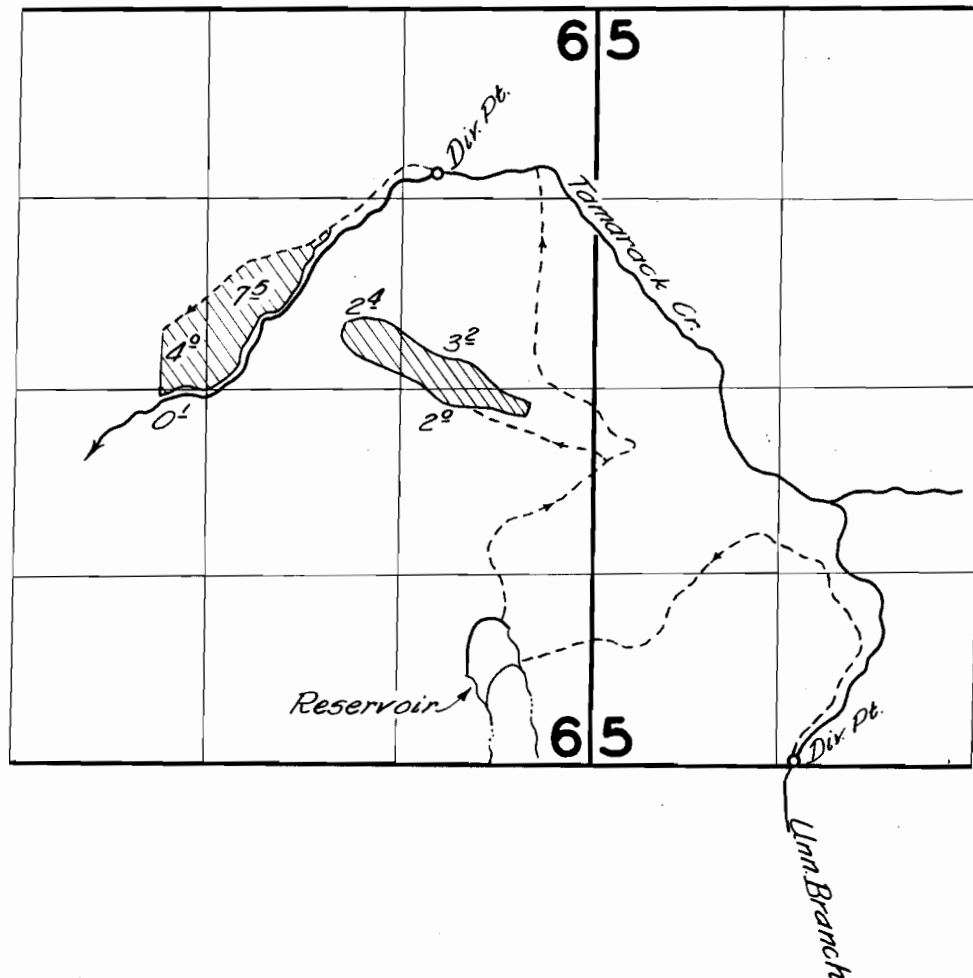

FINAL PROOF SURVEY
UNDER

R-26616 R-1806
Application No. 26617 Permit No. 23912
IN NAME OF

R.W. KEYS

Surveyed June 24 & 25 1959, by C.O. Baerleb