


T. IIS. R. IW. W.M.

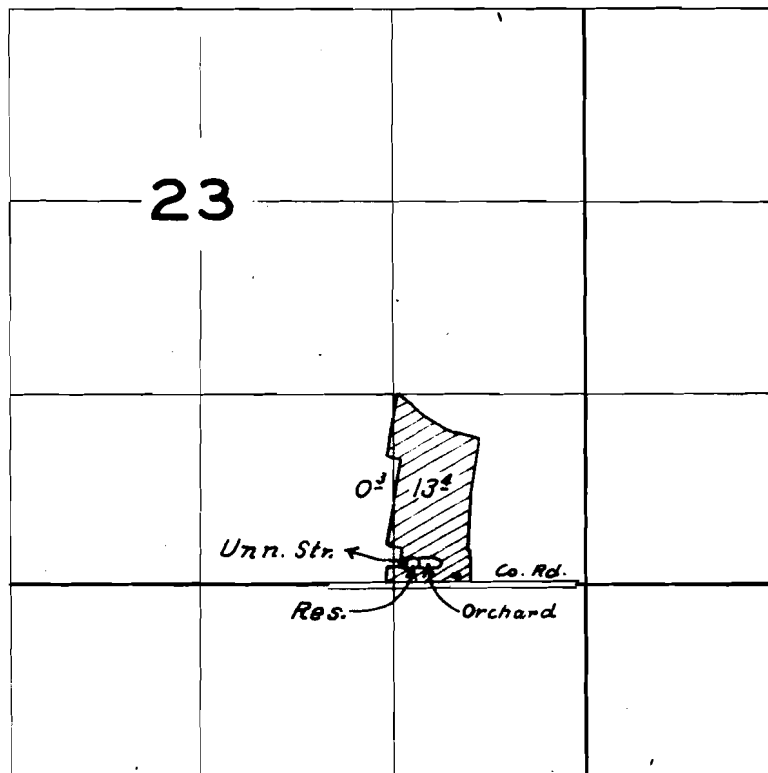

R-29565
29566

R-1811
23935

Donald C. & Clarice Davenport

Aug. 31, 1959, by R.H. Jackson