


T.21 S.R.46 E.W.M.

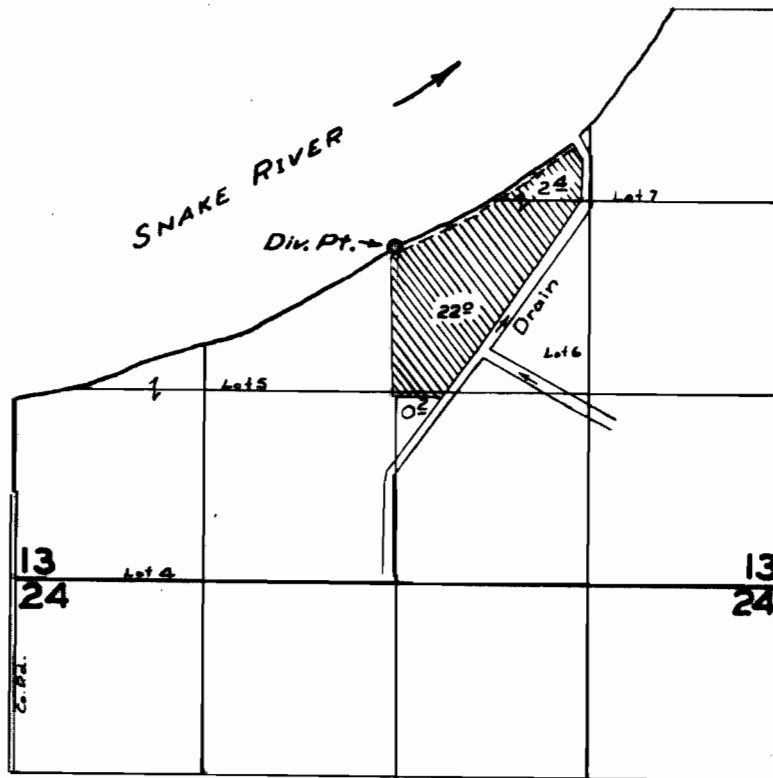

FINAL PROOF SURVEY UNDER

Application No. 30487 Permit No. 24011
IN NAME OF

CYRUS BISHOP

Surveyed 16 Sept. 1959, by M. Bishop