


T.38 S.R.5 W.W.M.

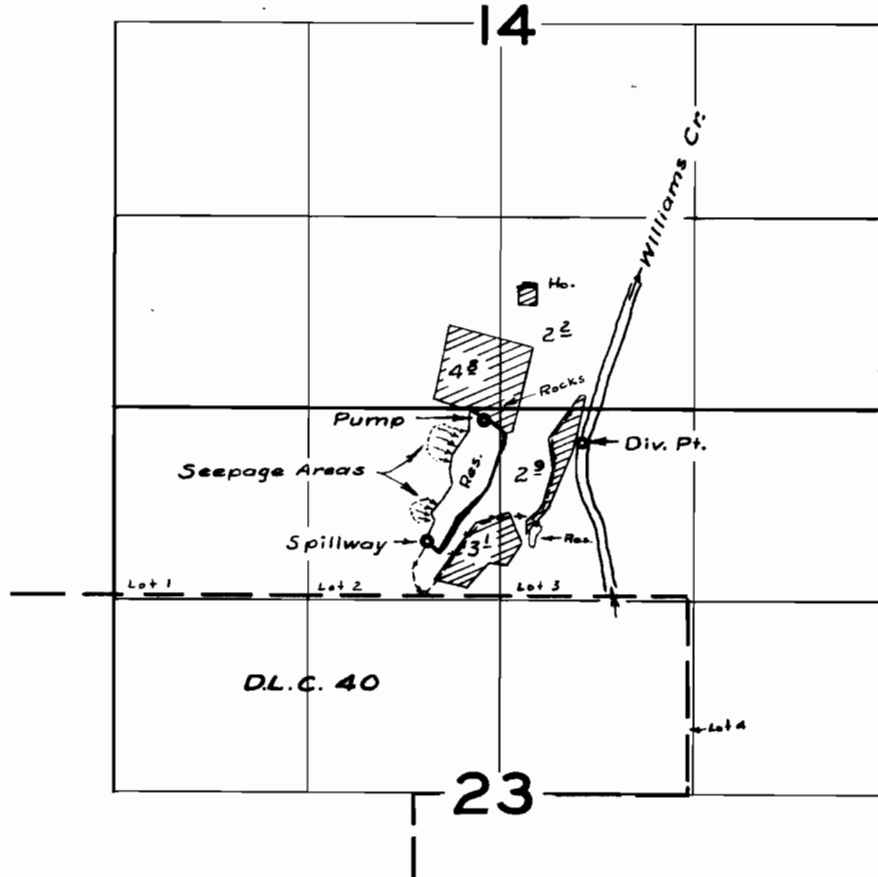

**FINAL PROOF SURVEY**  
UNDER

Application No. R-30521 30522 Permit No. R-1829 24032  
IN NAME OF

NORMAN WEBB

Surveyed 24 July 1959, by Tr. Bieh