


T.38 S.R.5 W.W.M.

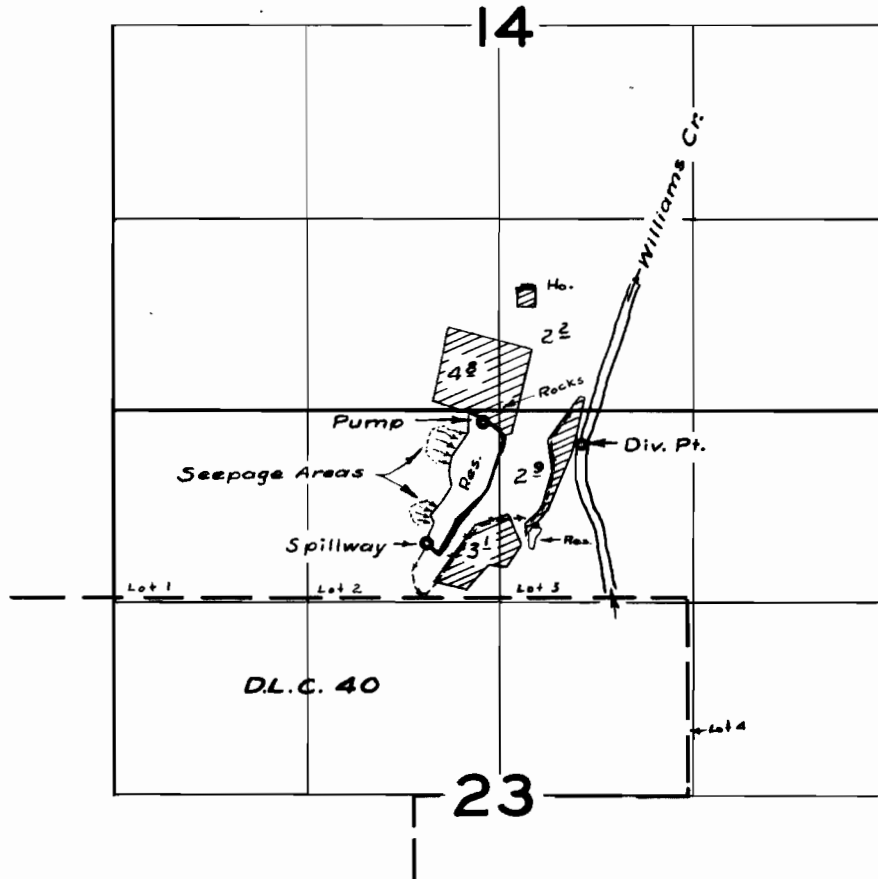

FINAL PROOF SURVEY UNDER

R-30521 *R-1829*
Application No. 30522 Permit No. 24032
IN NAME OF

NORMAN WEBB

Surveyed 24 July 1959, by m. Bish