


T.36S. R.6W.W.M.

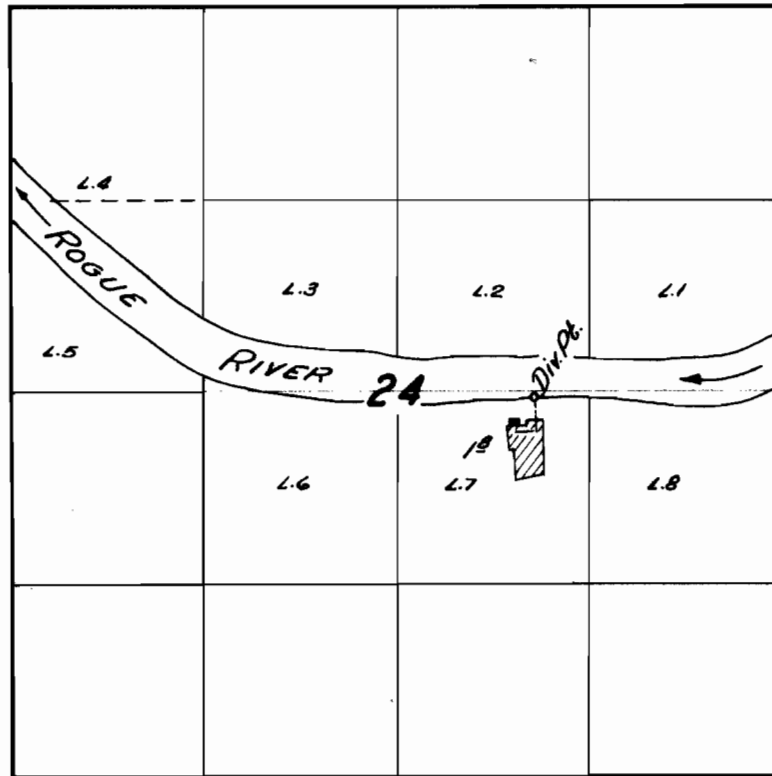

## FINAL PROOF SURVEY

UNDER

Application No. 30525 Permit No. 24035

IN NAME OF

H.E. Brown

Surveyed July 15 1959, by C. B. Smith