


T.10 S.R.I.E.W.M.

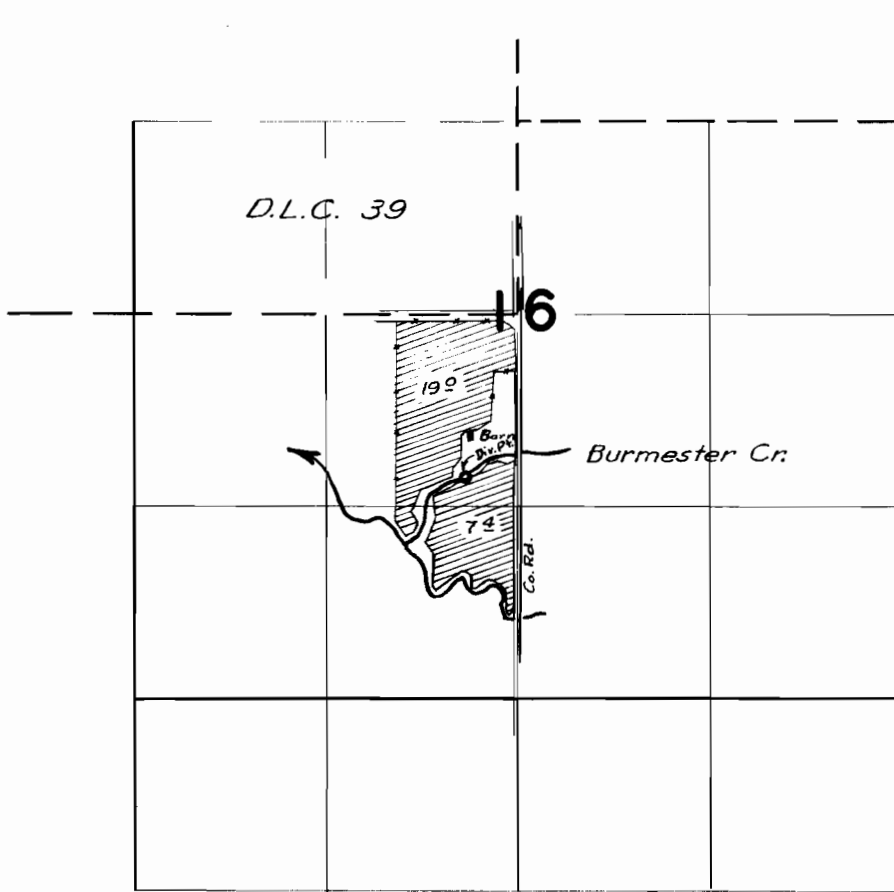

FINAL PROOF SURVEY
UNDER

Application No. 30693 Permit No. 24183
IN NAME OF

MELVIN F. TEIGEN

Surveyed 30 June 1959, by M. Bick