


T.17S. R.2W.W.M.

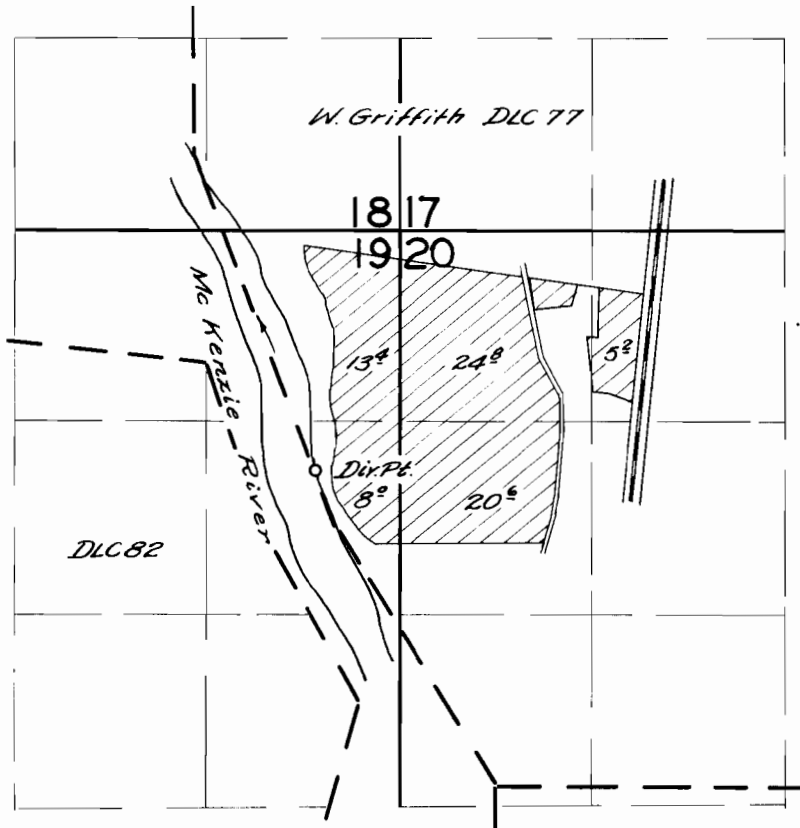

FINAL PROOF SURVEY
UNDER

Application No. 30732 Permit No. 24227
IN NAME OF

ANNA SANDGATHE

Surveyed *May 6* 1957, by *M. Bish*

DBQ-24-22