


T.37 S.R.7 W.W.M.

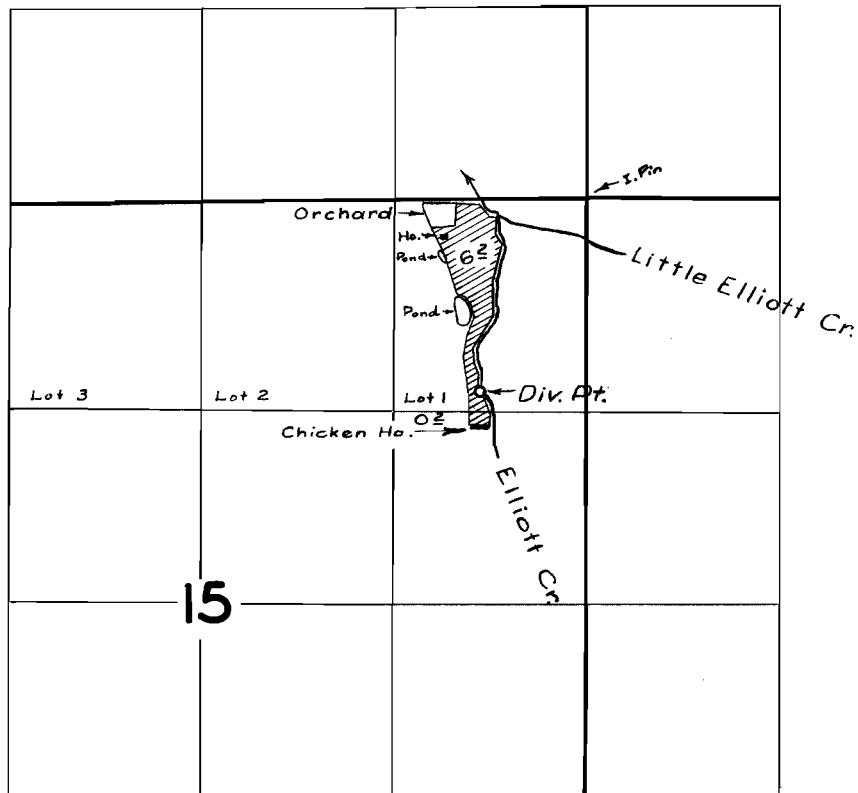

FINAL PROOF SURVEY UNDER

Application No. 30838 Permit No. 24272
IN NAME OF

EARL D. BRONSON

Surveyed 22 July 1959, by M. G. Sisk