


T. 9S. R. 1W.W.M.

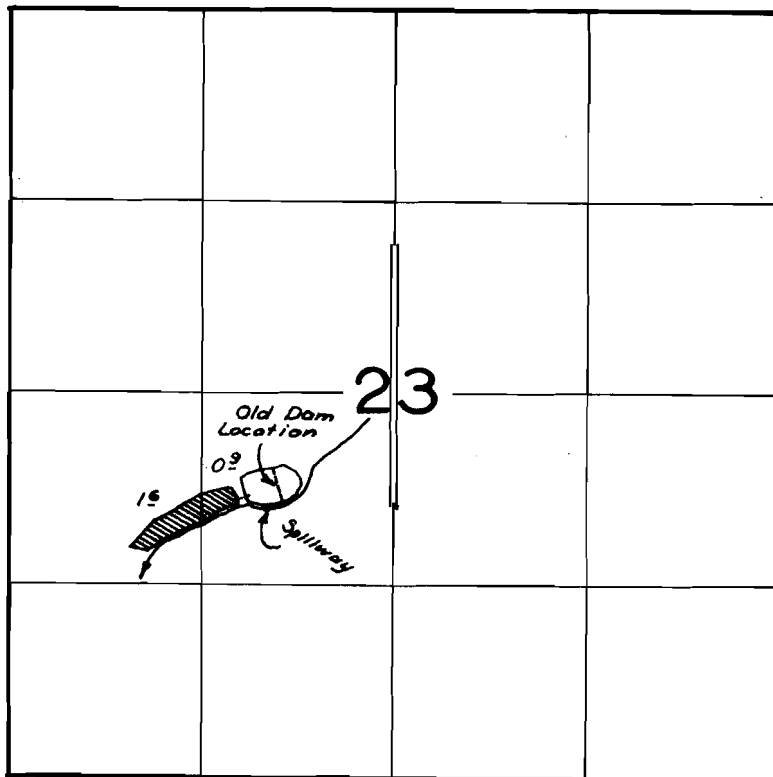

**FINAL PROOF SURVEY**  
UNDER

R-31107                      R-1904  
31108                        24404  
R-24875                     R-1128  
Application No. 24876    Permit No. 20198  
IN NAME OF

ARTHUR SANDNER

Surveyed Nov. 2 1959 by M. Bish