


T. 9S. R. 1W.W.M.

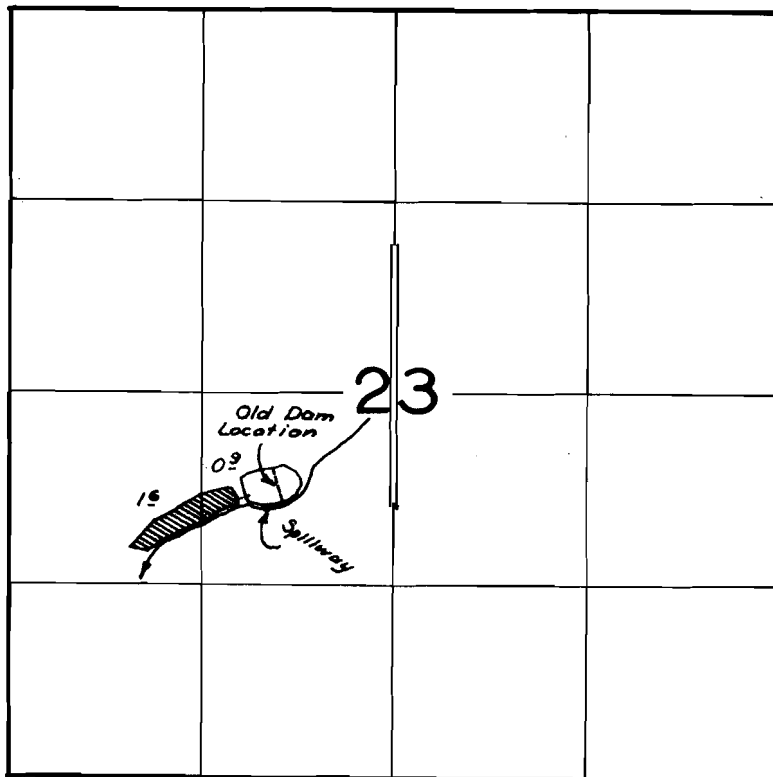

**FINAL PROOF SURVEY**  
UNDER

R-31107  
31108  
R-24875

R-1904  
24404  
R-1128

Application No. 24876 Permit No. 20198  
IN NAME OF

ARTHUR SANDNER

Surveyed Nov. 2 1959 by M. Bish