


T.37 S.R.7 W.W.M.

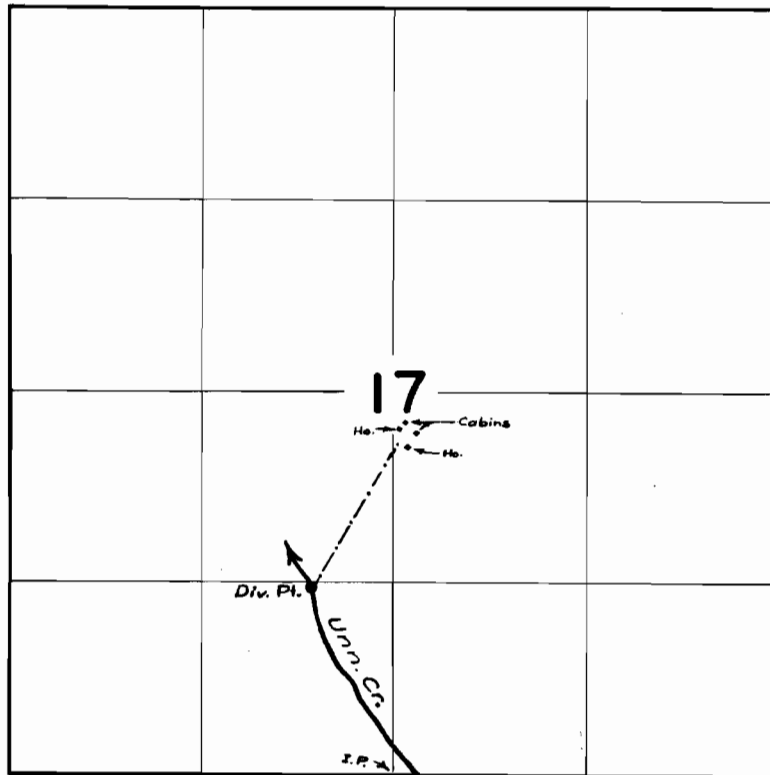

**FINAL PROOF SURVEY**  
UNDER

Application No. 31263 Permit No. 24631  
IN NAME OF

GLEN L. CHAPMAN

Surveyed 23 July 1959, by M. Bial