


T.38 S.R.5 W.W.M.

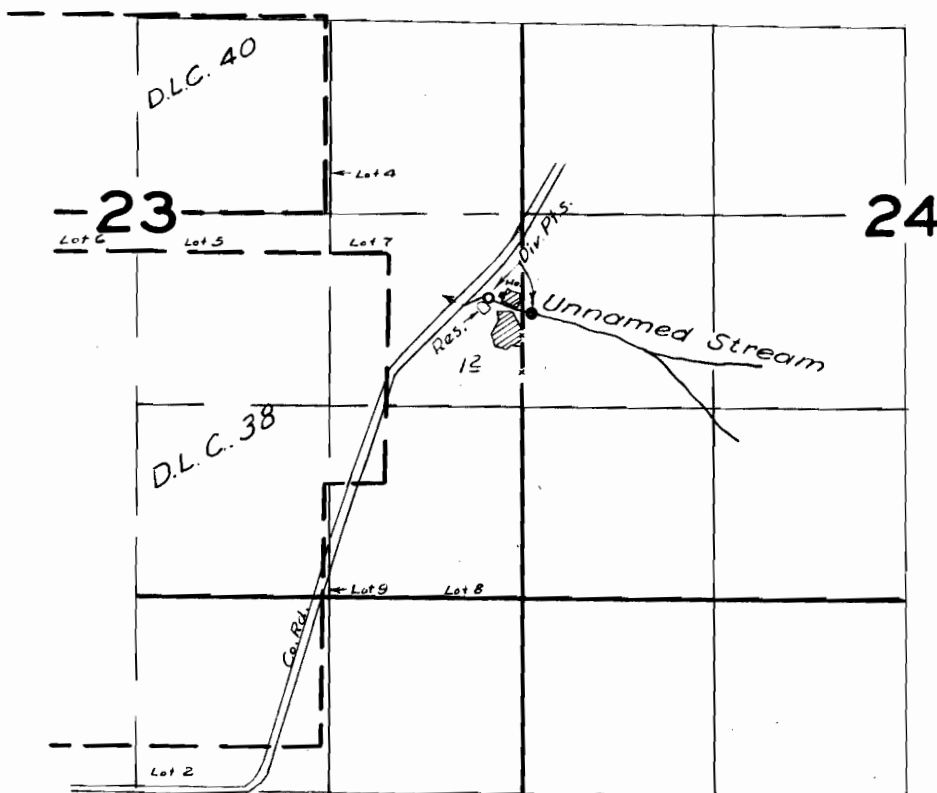

FINAL PROOF SURVEY UNDER

R-31245 R-1977
Application No. 31002 Permit No. 24675
IN NAME OF

LOUISA M. & FRED TOMPKINS

Surveyed 24 July 1959, by *M. Bick*