



T. 37 S. R. 5 W. W. M.

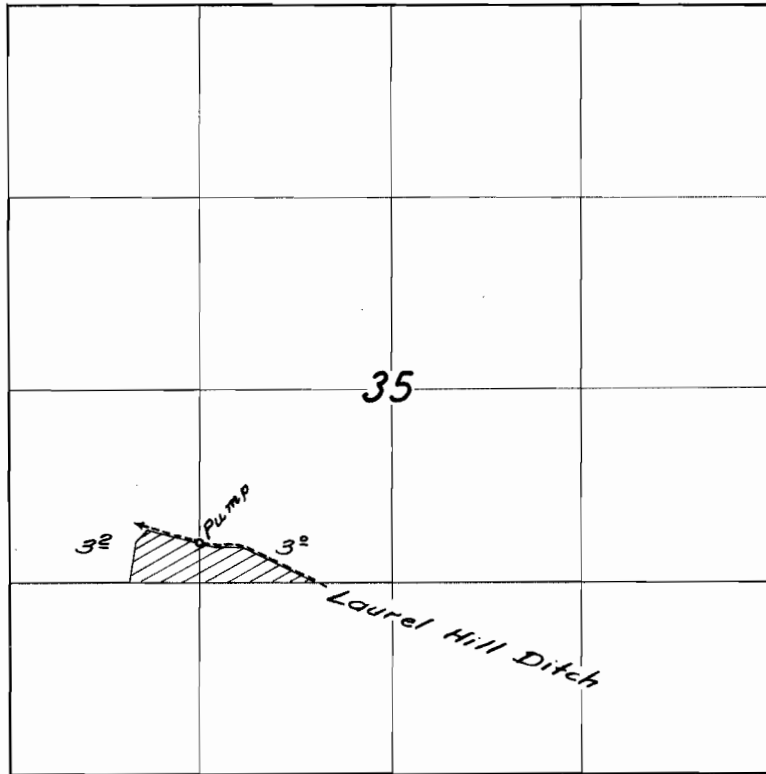

T. 38 S. R. 5 W. W. M.
SEC. 1

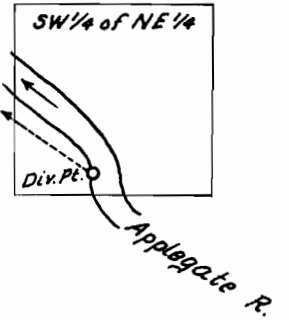

FINAL PROOF SURVEY

UNDER

Application No. 31546 Permit No. 24898

IN NAME OF

Joe & Mary E. Woodcock

Surveyed July 25 1959, by Ch. Bantel