


T.16 S. R. 5 W. W.M.

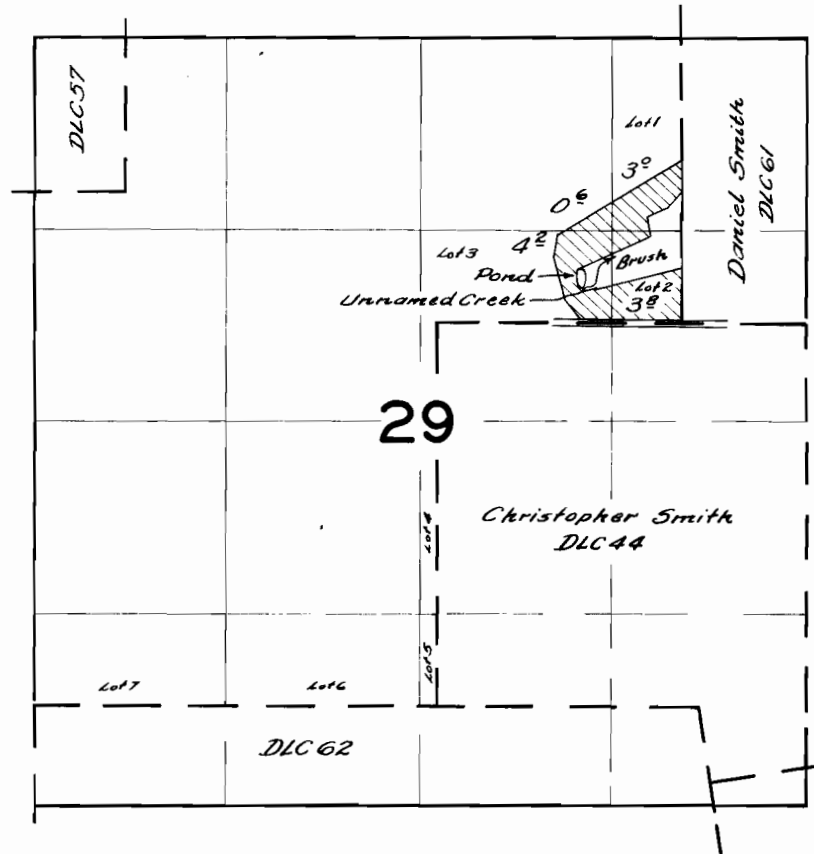

FINAL PROOF SURVEY
UNDER

Application No. 31558 Permit No. 24904
IN NAME OF

H. R. Hodson

Surveyed April 9, 1959, by *C. O. Baile*