


DECEMBER 24, 1980


Map changed to locate the land to agree with the legal description supplied by Murphy Electric Pump Ditch Company, Application #31689, Permit #24994

S. Brown

*SB*

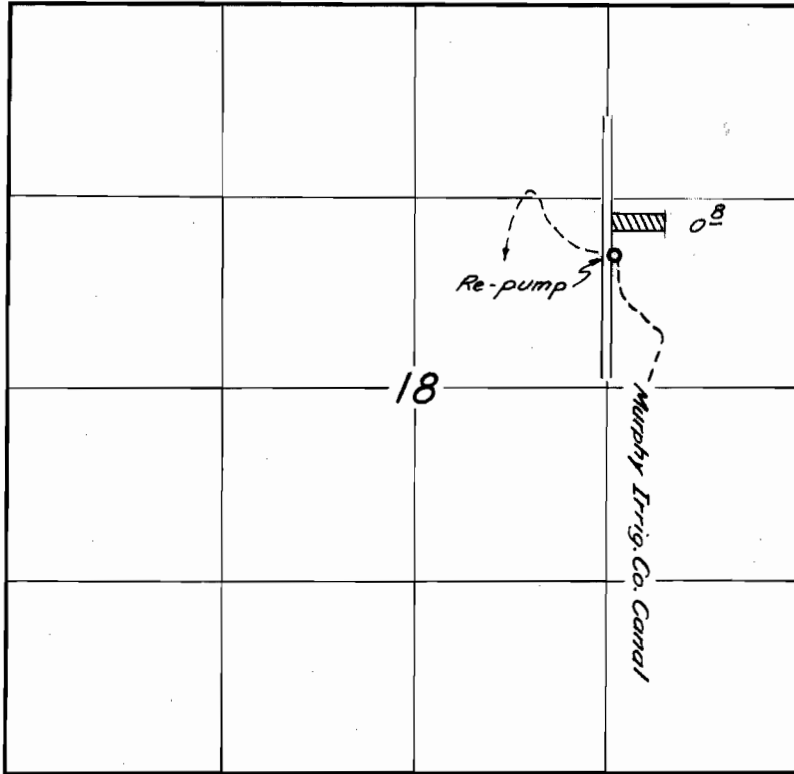

SEC 21  
se 1/4 nw 1/4

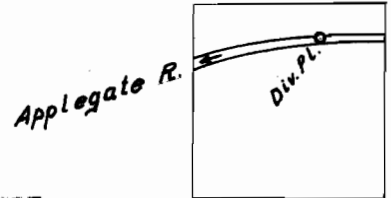

# FINAL PROOF SURVEY

*From Applicant's Map*

UNDER

Application No. 31689 Permit No. 24994

IN NAME OF

William E. Gilmore

Surveyed July 24, 1959, by C. O. Baule