


T.17S. R.6W.W.M.

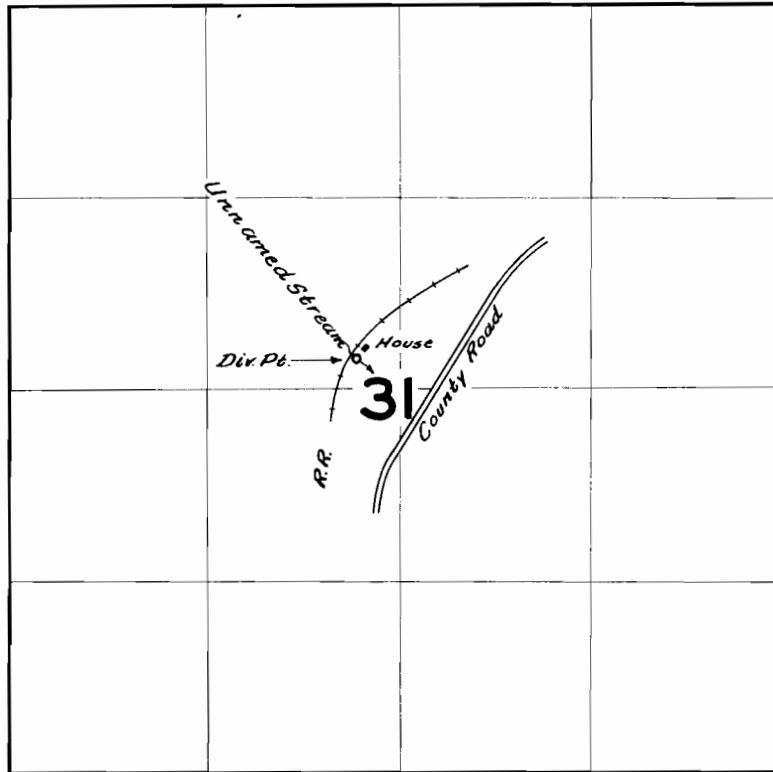

FINAL PROOF SURVEY
UNDER

Application No. 31796 Permit No. 25055
IN NAME OF

Archie N. Martin

Surveyed March 25 1959, by W. Bartels