


T.5N.R.36E.W.M.

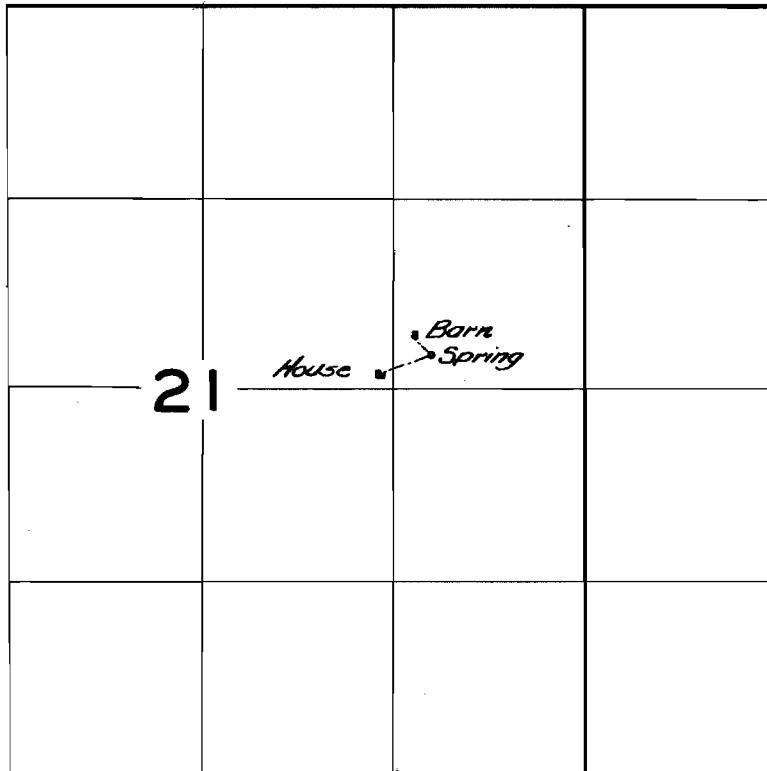

**FINAL PROOF SURVEY**

UNDER

Application No. 32055 Permit No. 25298

IN NAME OF

Levi Albert Reynolds

Surveyed Oct. 26 1959, by C. O. Bartlett