


T. 13 S.R. 6 W.W.M.

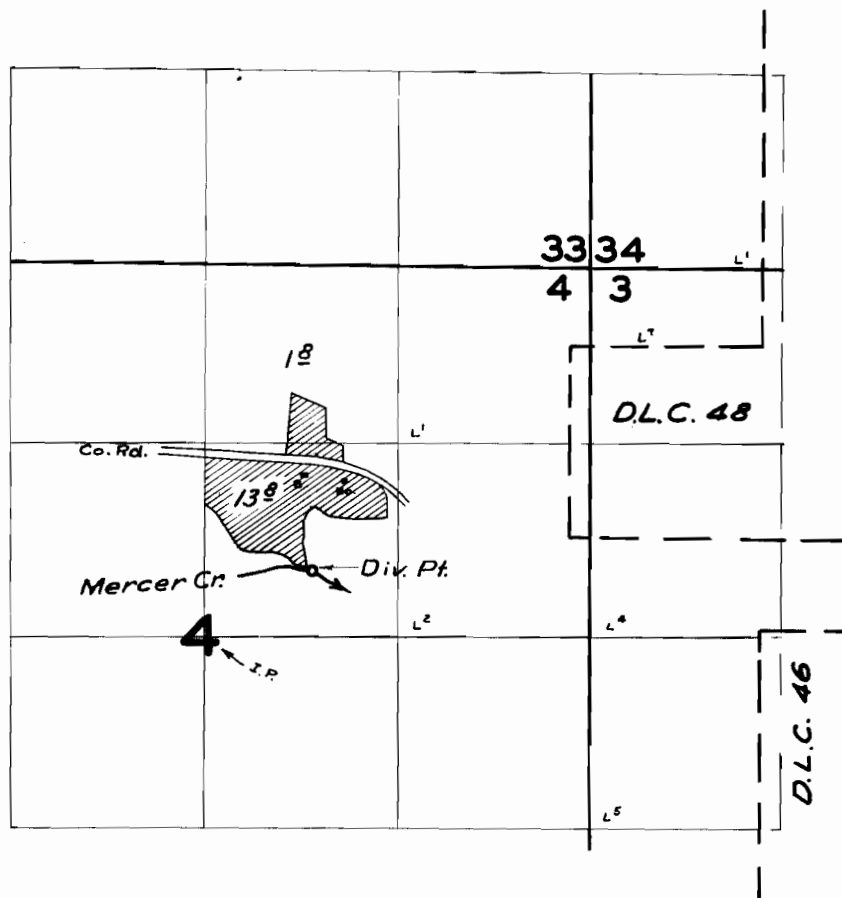

FINAL PROOF SURVEY
UNDER

Application No. 32188 Permit No. 25391
IN NAME OF

GLENN & MARY DECKER

Surveyed 2 Oct. 1958, by C.O. Bartels