


T. 4N. R. 7W. W.M.

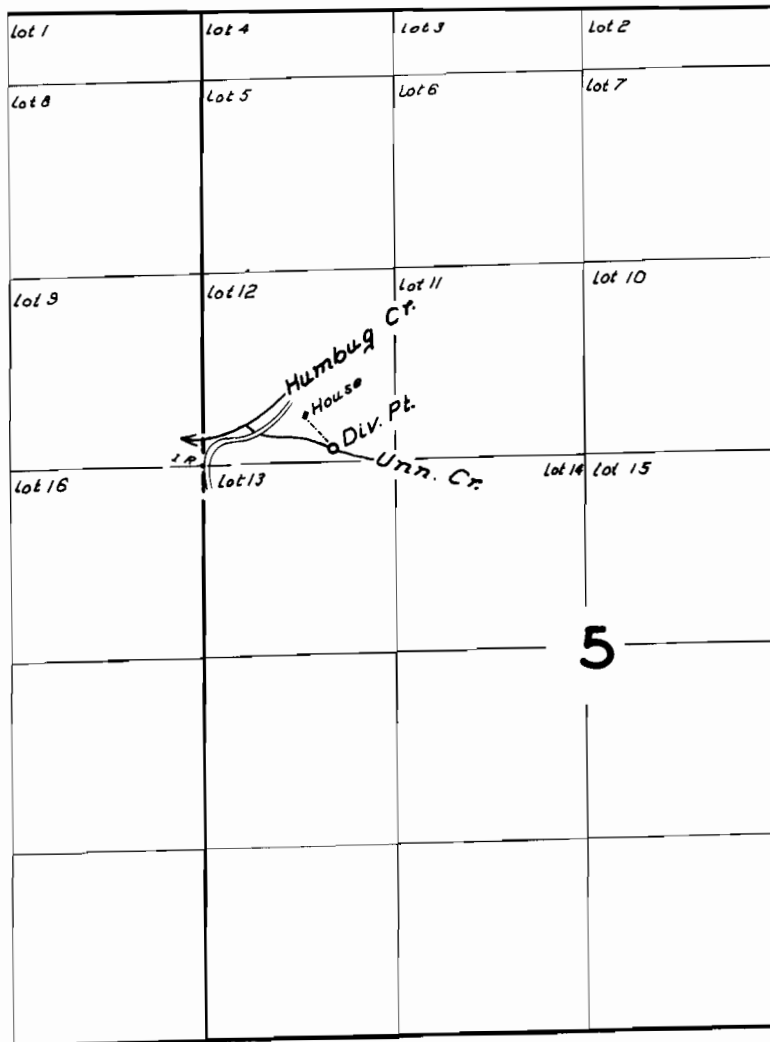

**FINAL PROOF SURVEY**  
UNDER

Application No. 32494... Permit No. 25653...  
IN NAME OF

*Henry E. Carlson*

Surveyed June 30 1959, by *C.O. Bartels*...