


# T. 2S. R. 2E. W.M.

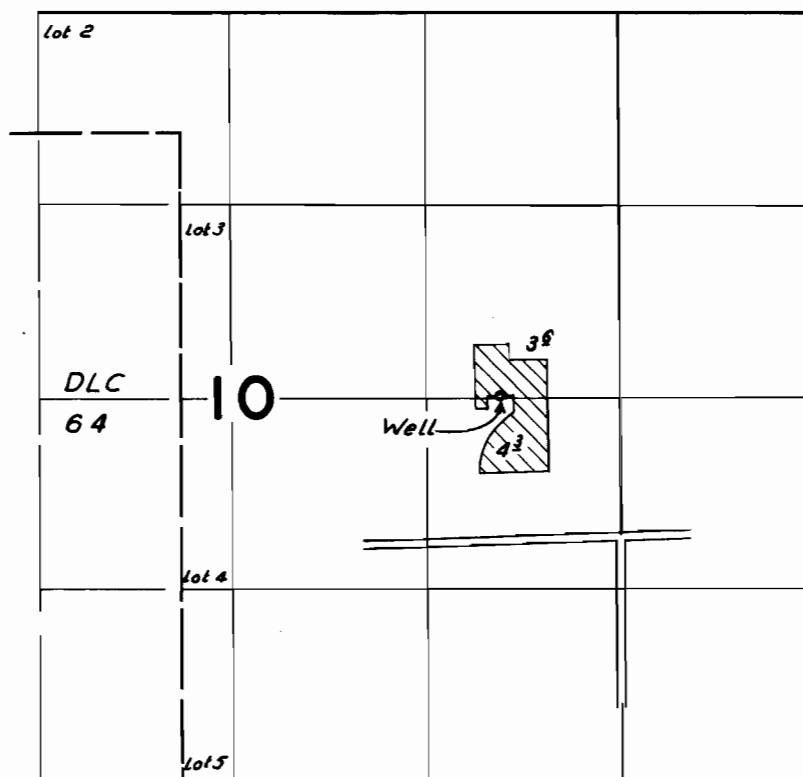

## FINAL PROOF SURVEY UNDER

Application No. *G331*..... Permit No. *G416*.....  
IN NAME OF

*F. Randahl Brown*

Surveyed *Sept. 8* 1959, by *C. O. Bartels*