


T.36S. R.6W.W.M.

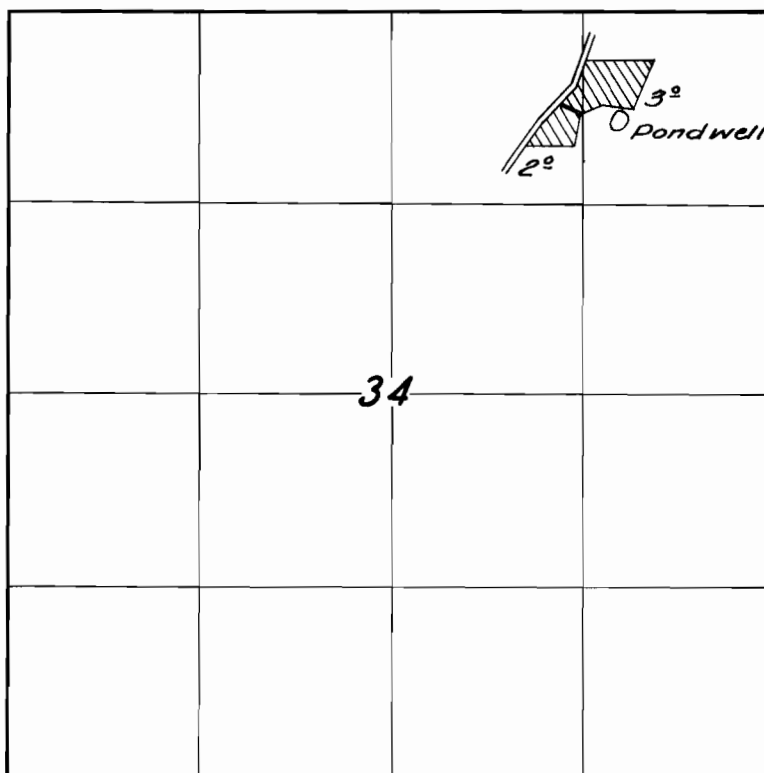

FINAL PROOF SURVEY

EX-102

Application No. G-577 Permit No. G-524

IN FAVOR OF

C.E. & Grace Gilkey

Surveyed July 15, 1959, by C.D. Bartlett