


T.16S. R.4W.W.M.

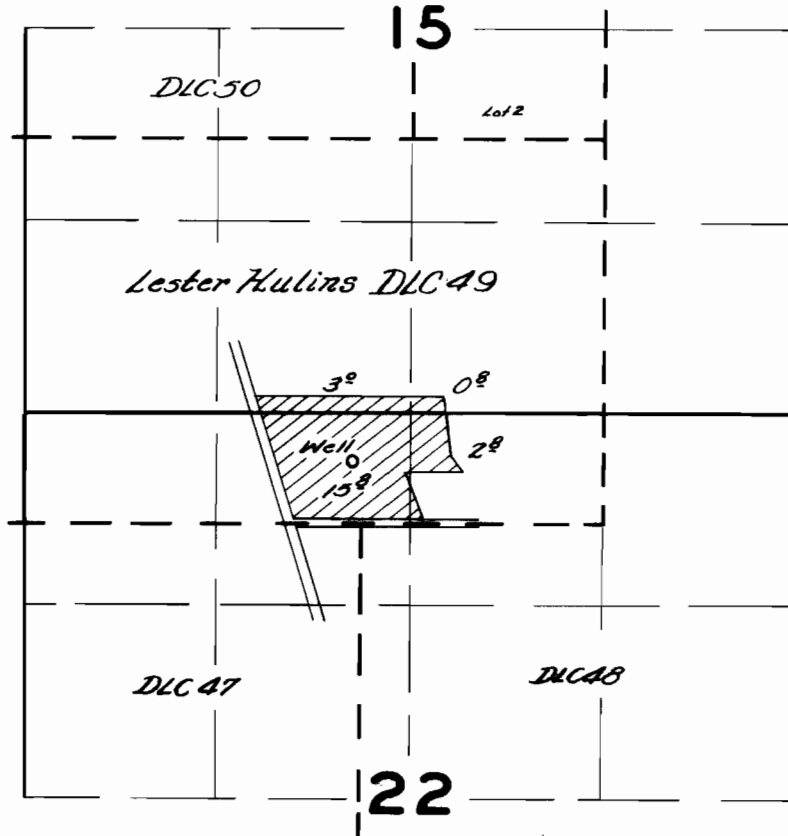

**FINAL PROOF SURVEY**  
UNDER

Application No. *G-721* Permit No. *G-625*  
IN NAME OF

*Merl Watts Jr.*

Surveyed *April 13* 1959, by *C. W. Gatch*