


T.6 N. R.35 E.W.M.

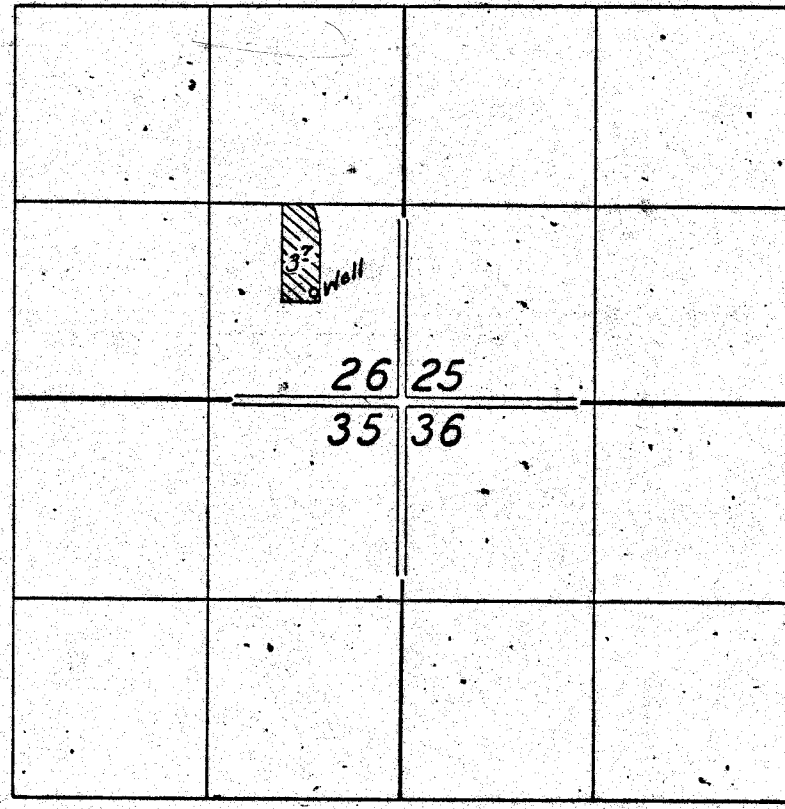

FINAL PROOF SURVEY

UNDER

Application No. G-1009 Permit No. G-974

IN NAME OF

Lawrence & Pauline K. Cutts

Surveyed Oct. 24, 1959, by C. O. Bartels