


G-1279

27424

T.6N.R.34E.W.M.

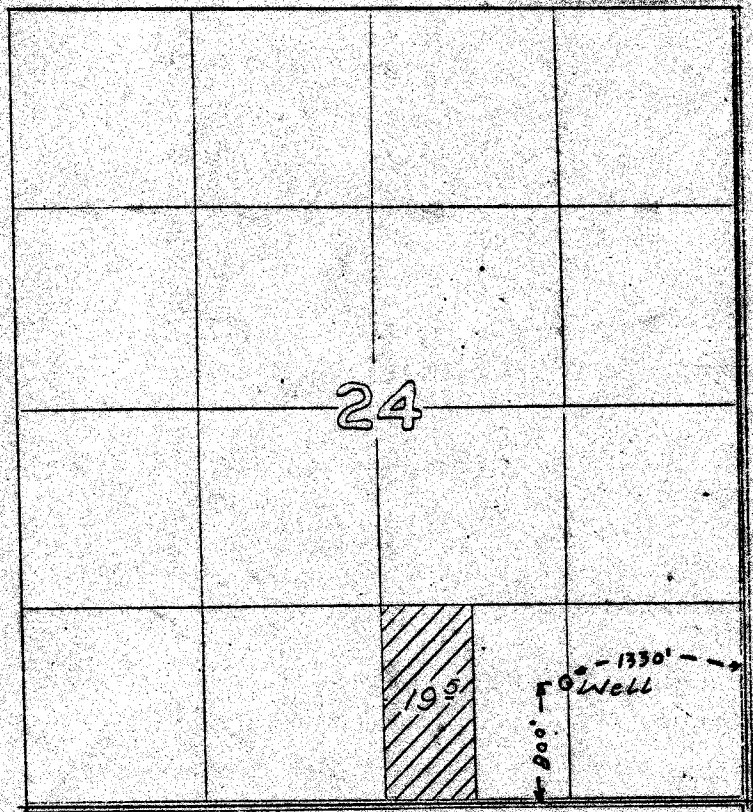

RECEIVED
MAY 2 1950
STATE ENGINEER

FRANCES FITZSIMMONS

Application No. G-1401
Permit No. G-1279