


U-440
27425

T.39 S.R.11 E.W.M.

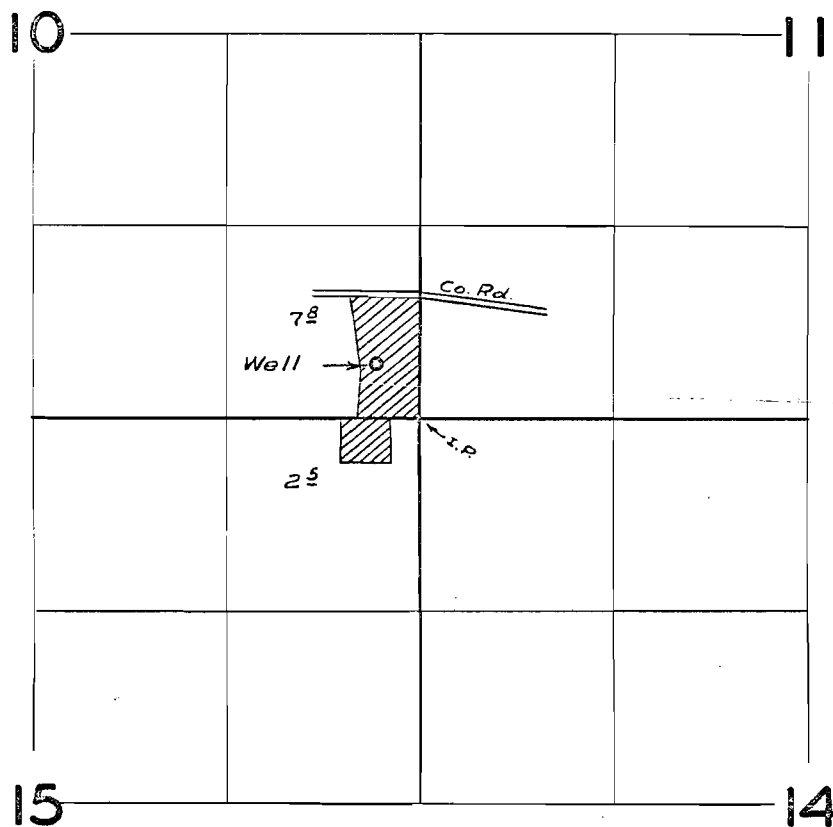

FINAL PROOF SURVEY

UNDER

Application No. U-488 Permit No. U-440

IN NAME OF

LOST RIVER CEMETERY ASSOC.

Surveyed 10 Oct. 1959, by W. B. Bish

CNO-65K-77