


U-640

22429

T. 6N.R. 35E.W.M.

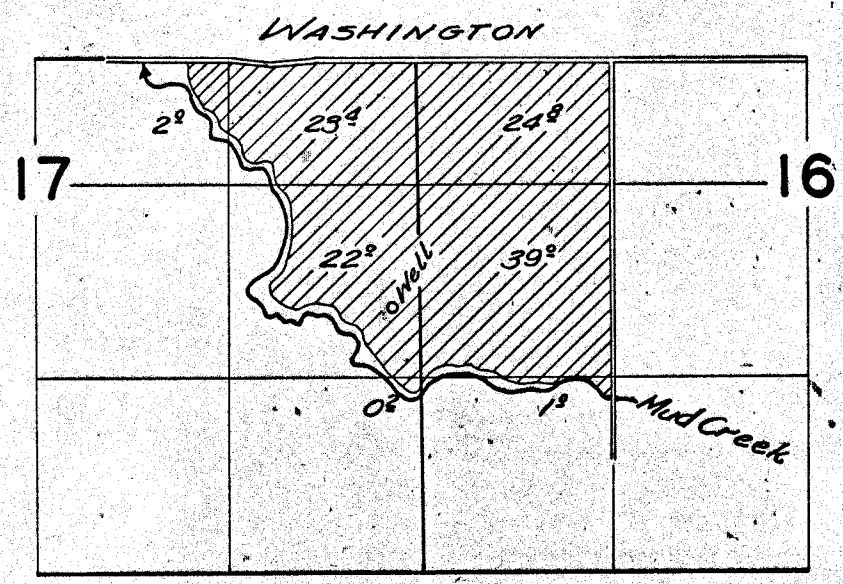

FINAL PROOF SURVEY

UNDER

Application No. U-719 Permit No. U-640

IN NAME OF

Estate of Frank M. Lockwood

Surveyed Oct. 23, 1959, by C. O. Baile