


U-813

721

27431

T.29 S.R.17 E.W.M.

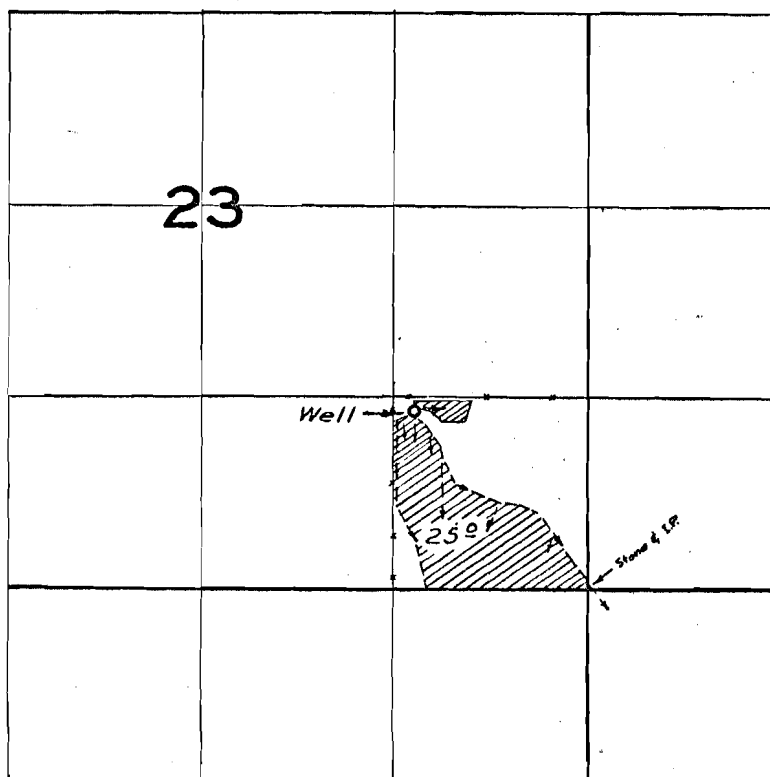

FINAL PROOF SURVEY UNDER

Application No. U-813 Permit No. U-721
IN NAME OF

RAYMOND & DORA YAGER Phettplace

Surveyed 15 May 1959, by M. Bish

1959-C