


T. 19 S. R. 47 E. W. M.

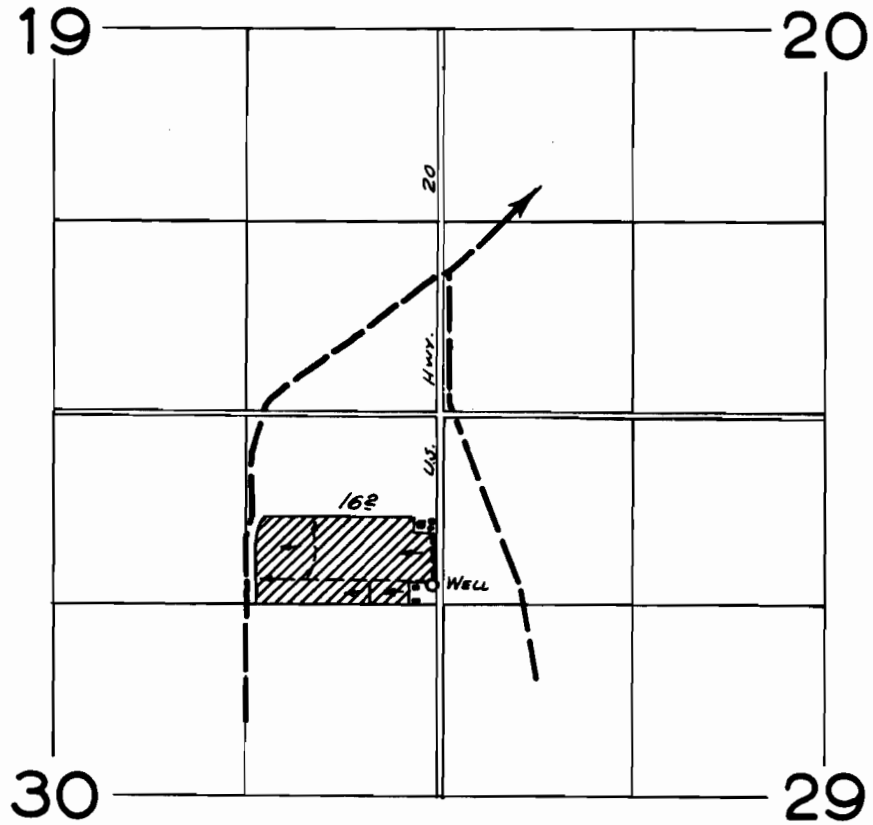

FINAL PROOF SURVEY

UNDER

Application No. U-816 Permit No. U-723

IN NAME OF

CHARLEY & HOPE GRIDER

Surveyed Sept. 21 1959, by R. H. Jackson