


T. 38& 39S. R. 8E. W.M.

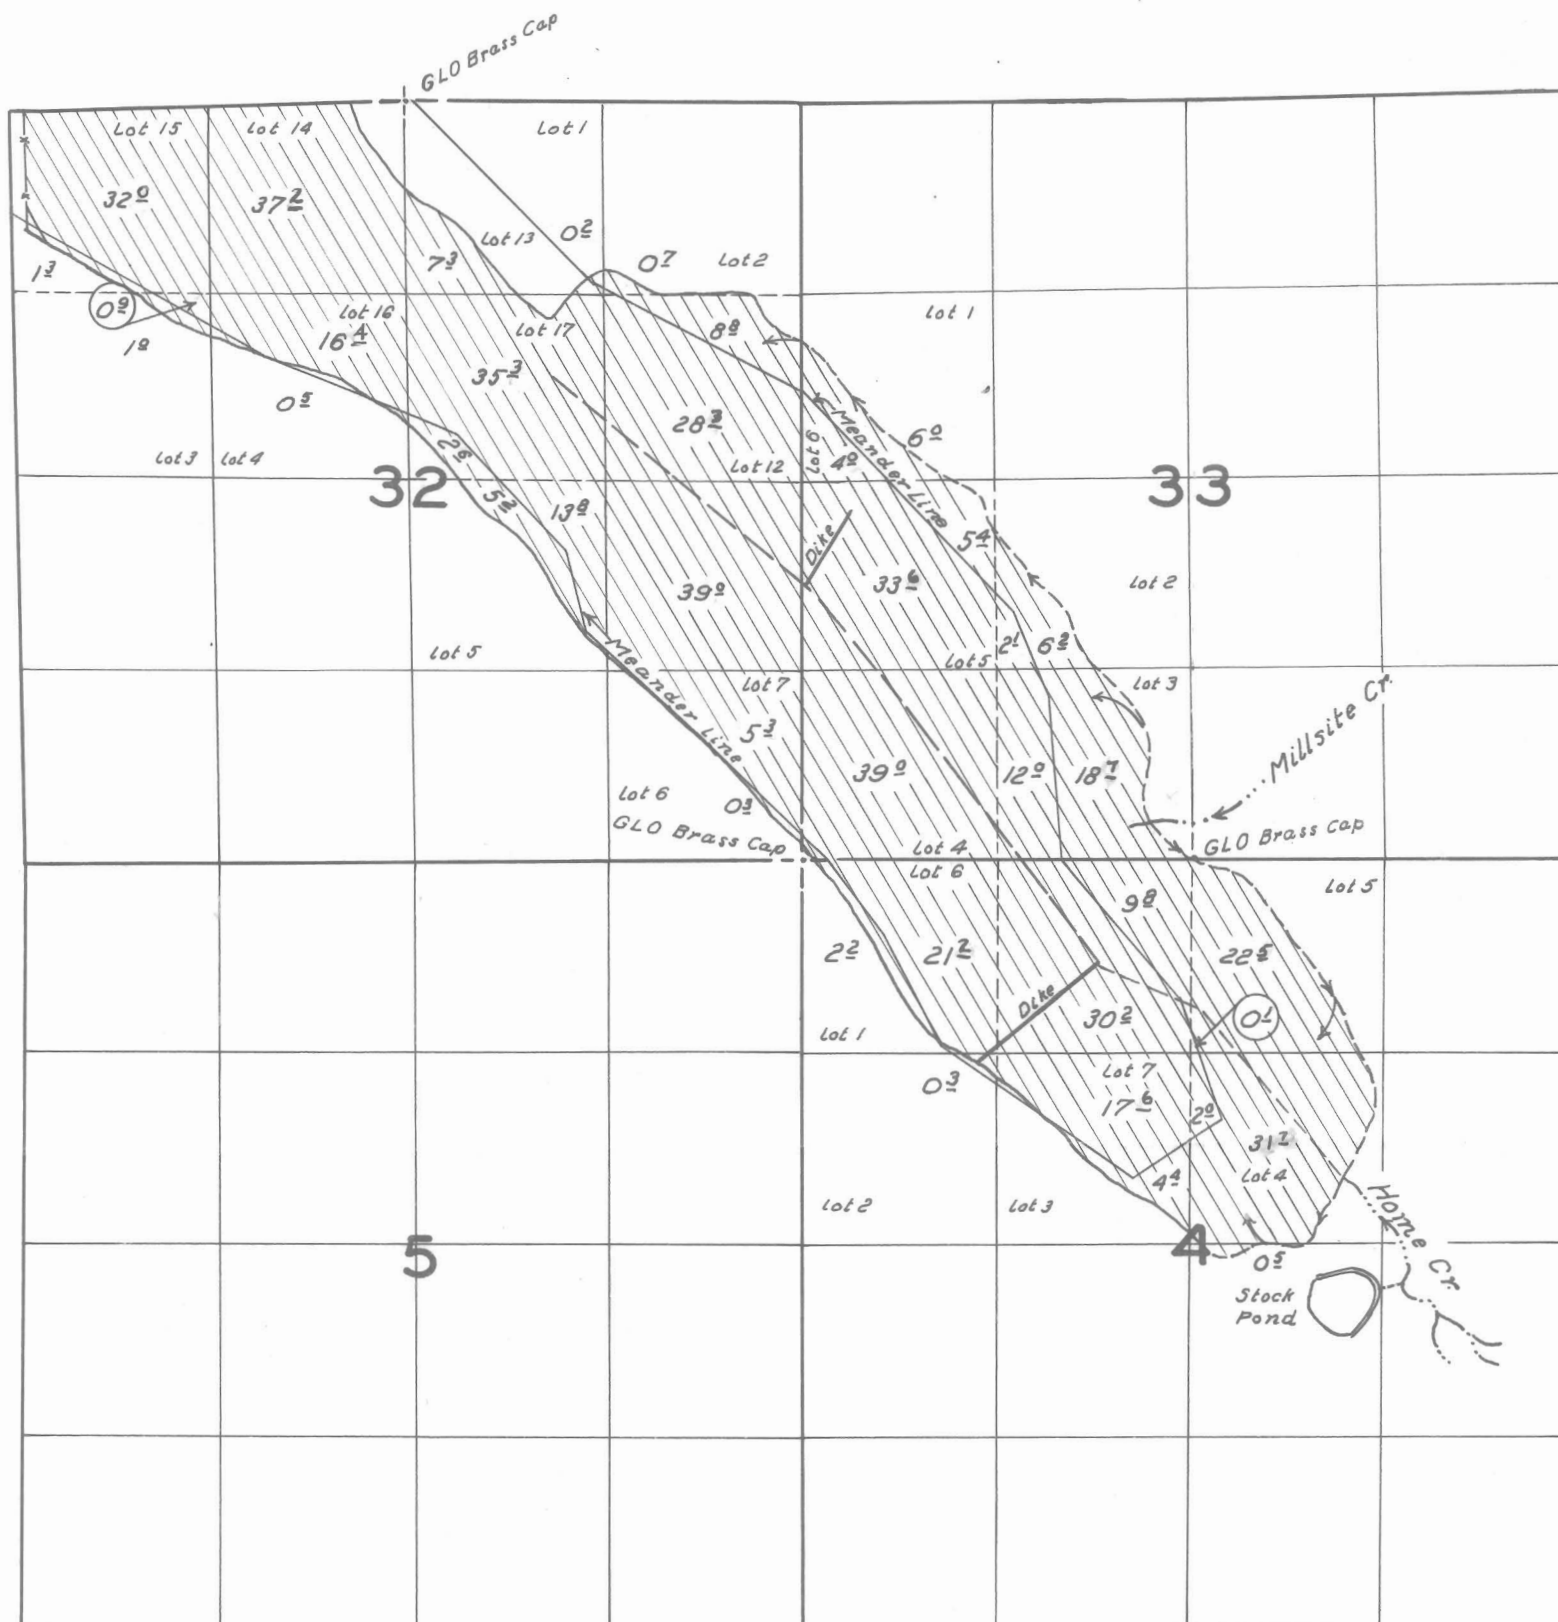

FINAL PROOF SURVEY

UNDER

APPLICATION NO. 24010 PERMIT NO. 18936

IN NAME OF

IDA MOCHETTA Z

SURVEYED OCT. 21, 1959; BY R. H. JACKSON