


T.17S. R.2W.W.M.

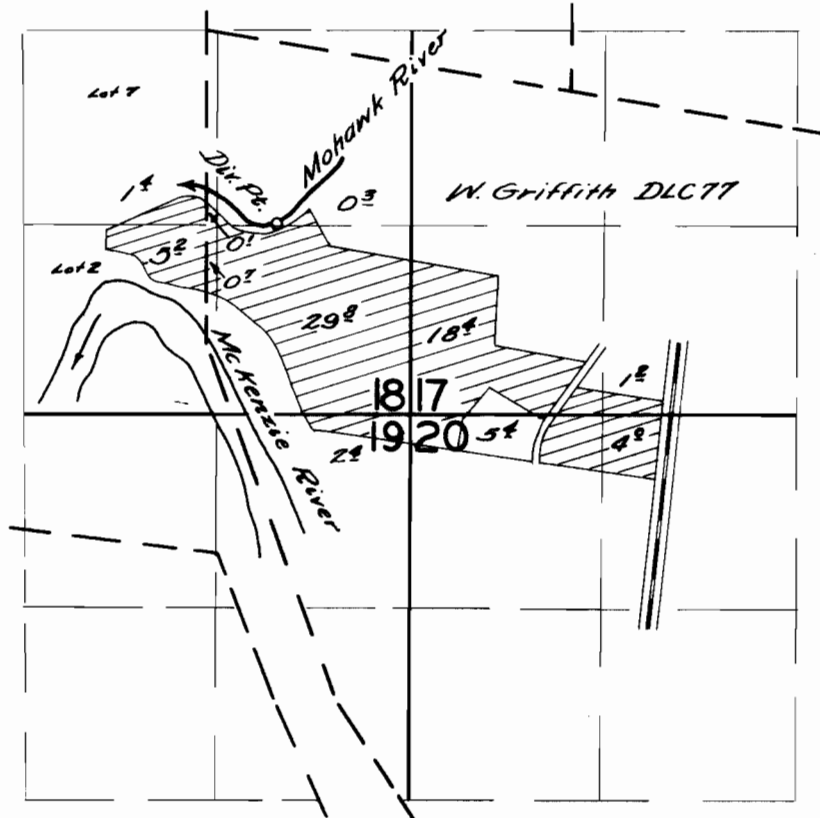

**FINAL PROOF SURVEY**  
UNDER

Application No. 25312 Permit No. 1986A  
IN NAME OF

Christian Logging Co.

Surveyed May 9 1957, by M. Bish