


T.37S. R.5W.W.M.

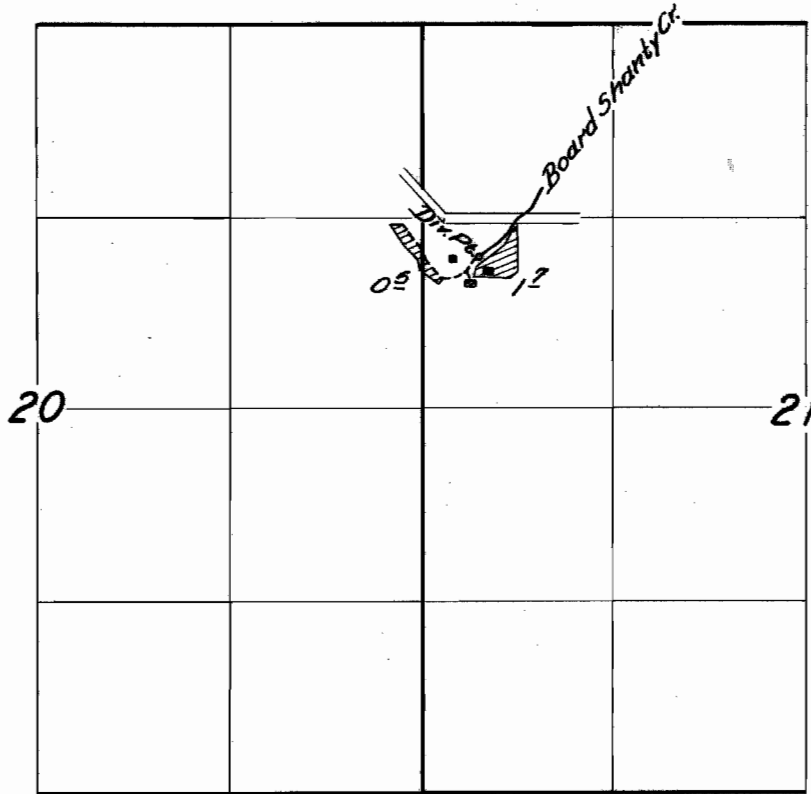

FINAL PROOF SURVEY

UNDER

Application No. 26543 Permit No. 20800

IN NAME OF

Walter L. Brown

Surveyed July 20 1959, by CB Bartlett