


T. 2S. R. 4E. W.M.

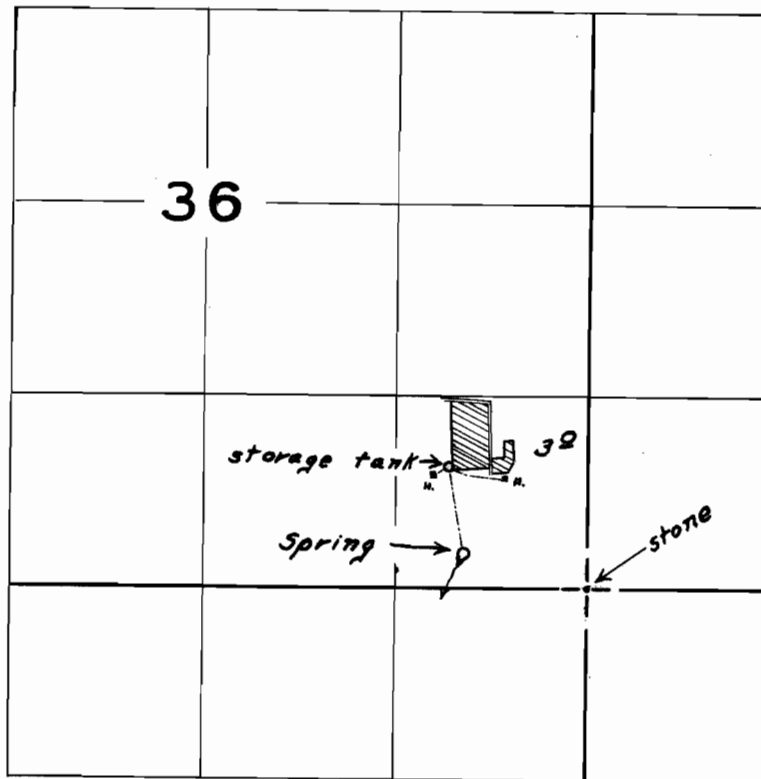

FINAL PROOF SURVEY
UNDER

Application No. 26598 Permit No. 20953
IN NAME OF

A. E. & Esther Larsen

Surveyed Aug. 26 1958, by W. N. Perry