


T. 6S. R. 1E&1W. W.M.

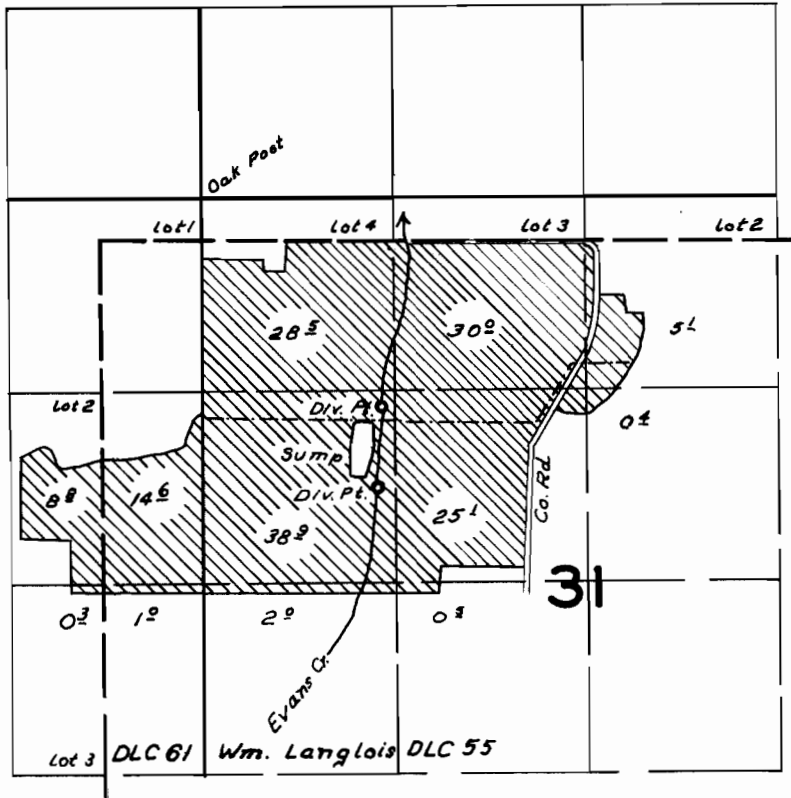

FINAL PROOF SURVEY
UNDER

Application No. 25848... Permit No. 21916...
IN NAME OF

Oscar H. Loe

Surveyed *March 16/1959*, by *R.H. Jackson*