


T.14 & 13 S.R.7 W.W.M.

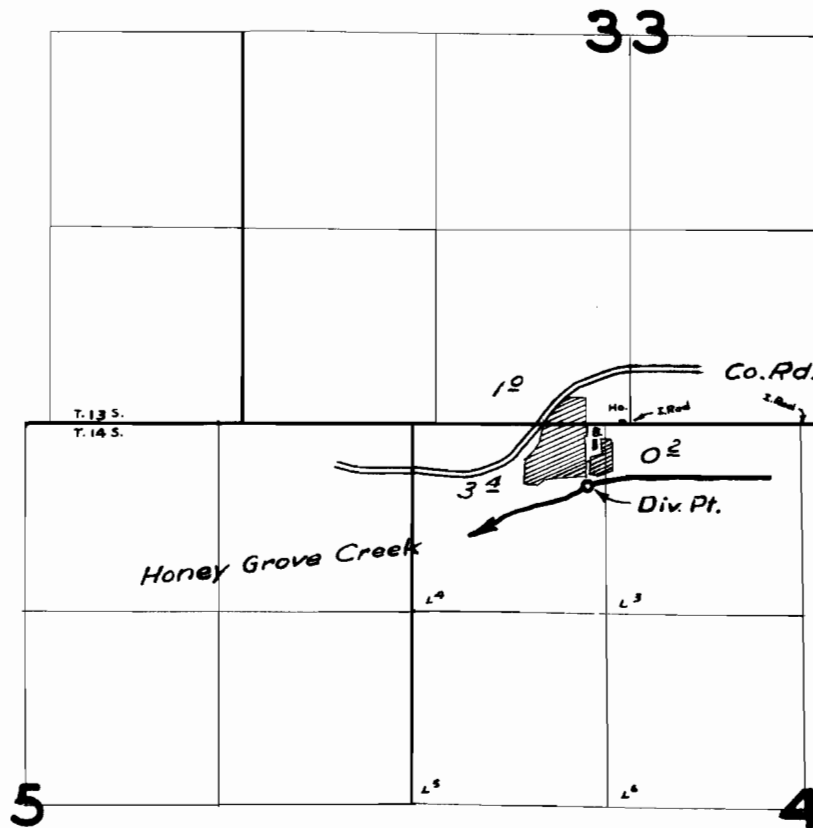

FINAL PROOF SURVEY UNDER

Application No. 28143 Permit No. 22149
IN NAME OF

K.N. SPENCER

Surveyed 12 Mar. 1959, by M. Bish