



T. 36 S. R. 7 E. W. M.

UPPER
KLAMATH
LAKE

FINAL PROOF SURVEY
IN NAME OF

PAGE H. - MARJORIE N. LAMOREAUX
APPLICATION NO. 14426 PERMIT NO. 22472
SURVEYED OCT. 6, 7, 10, 12, 13, 1959

BY
R. H. JACKSON
1959-R

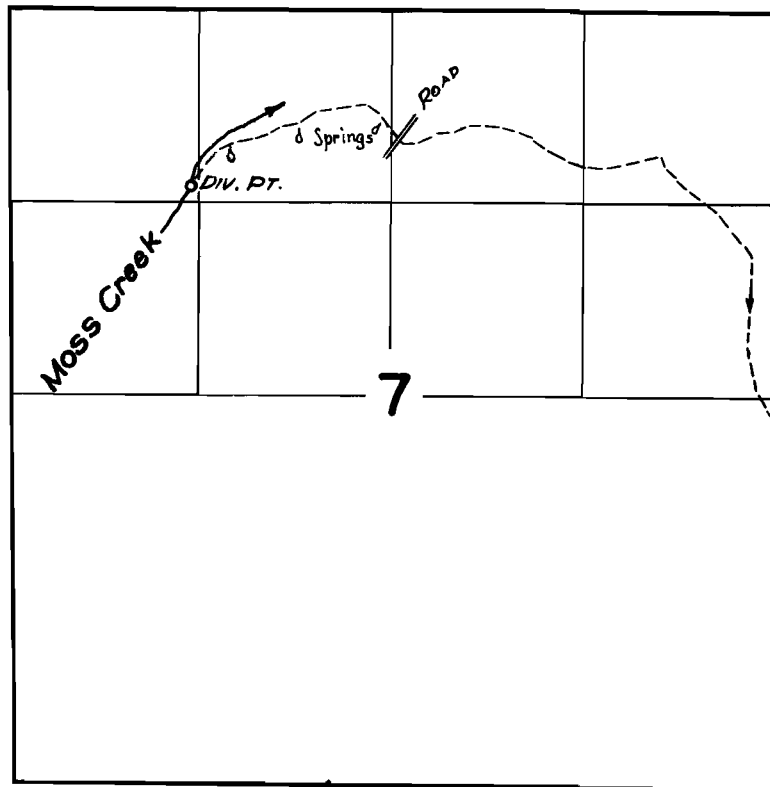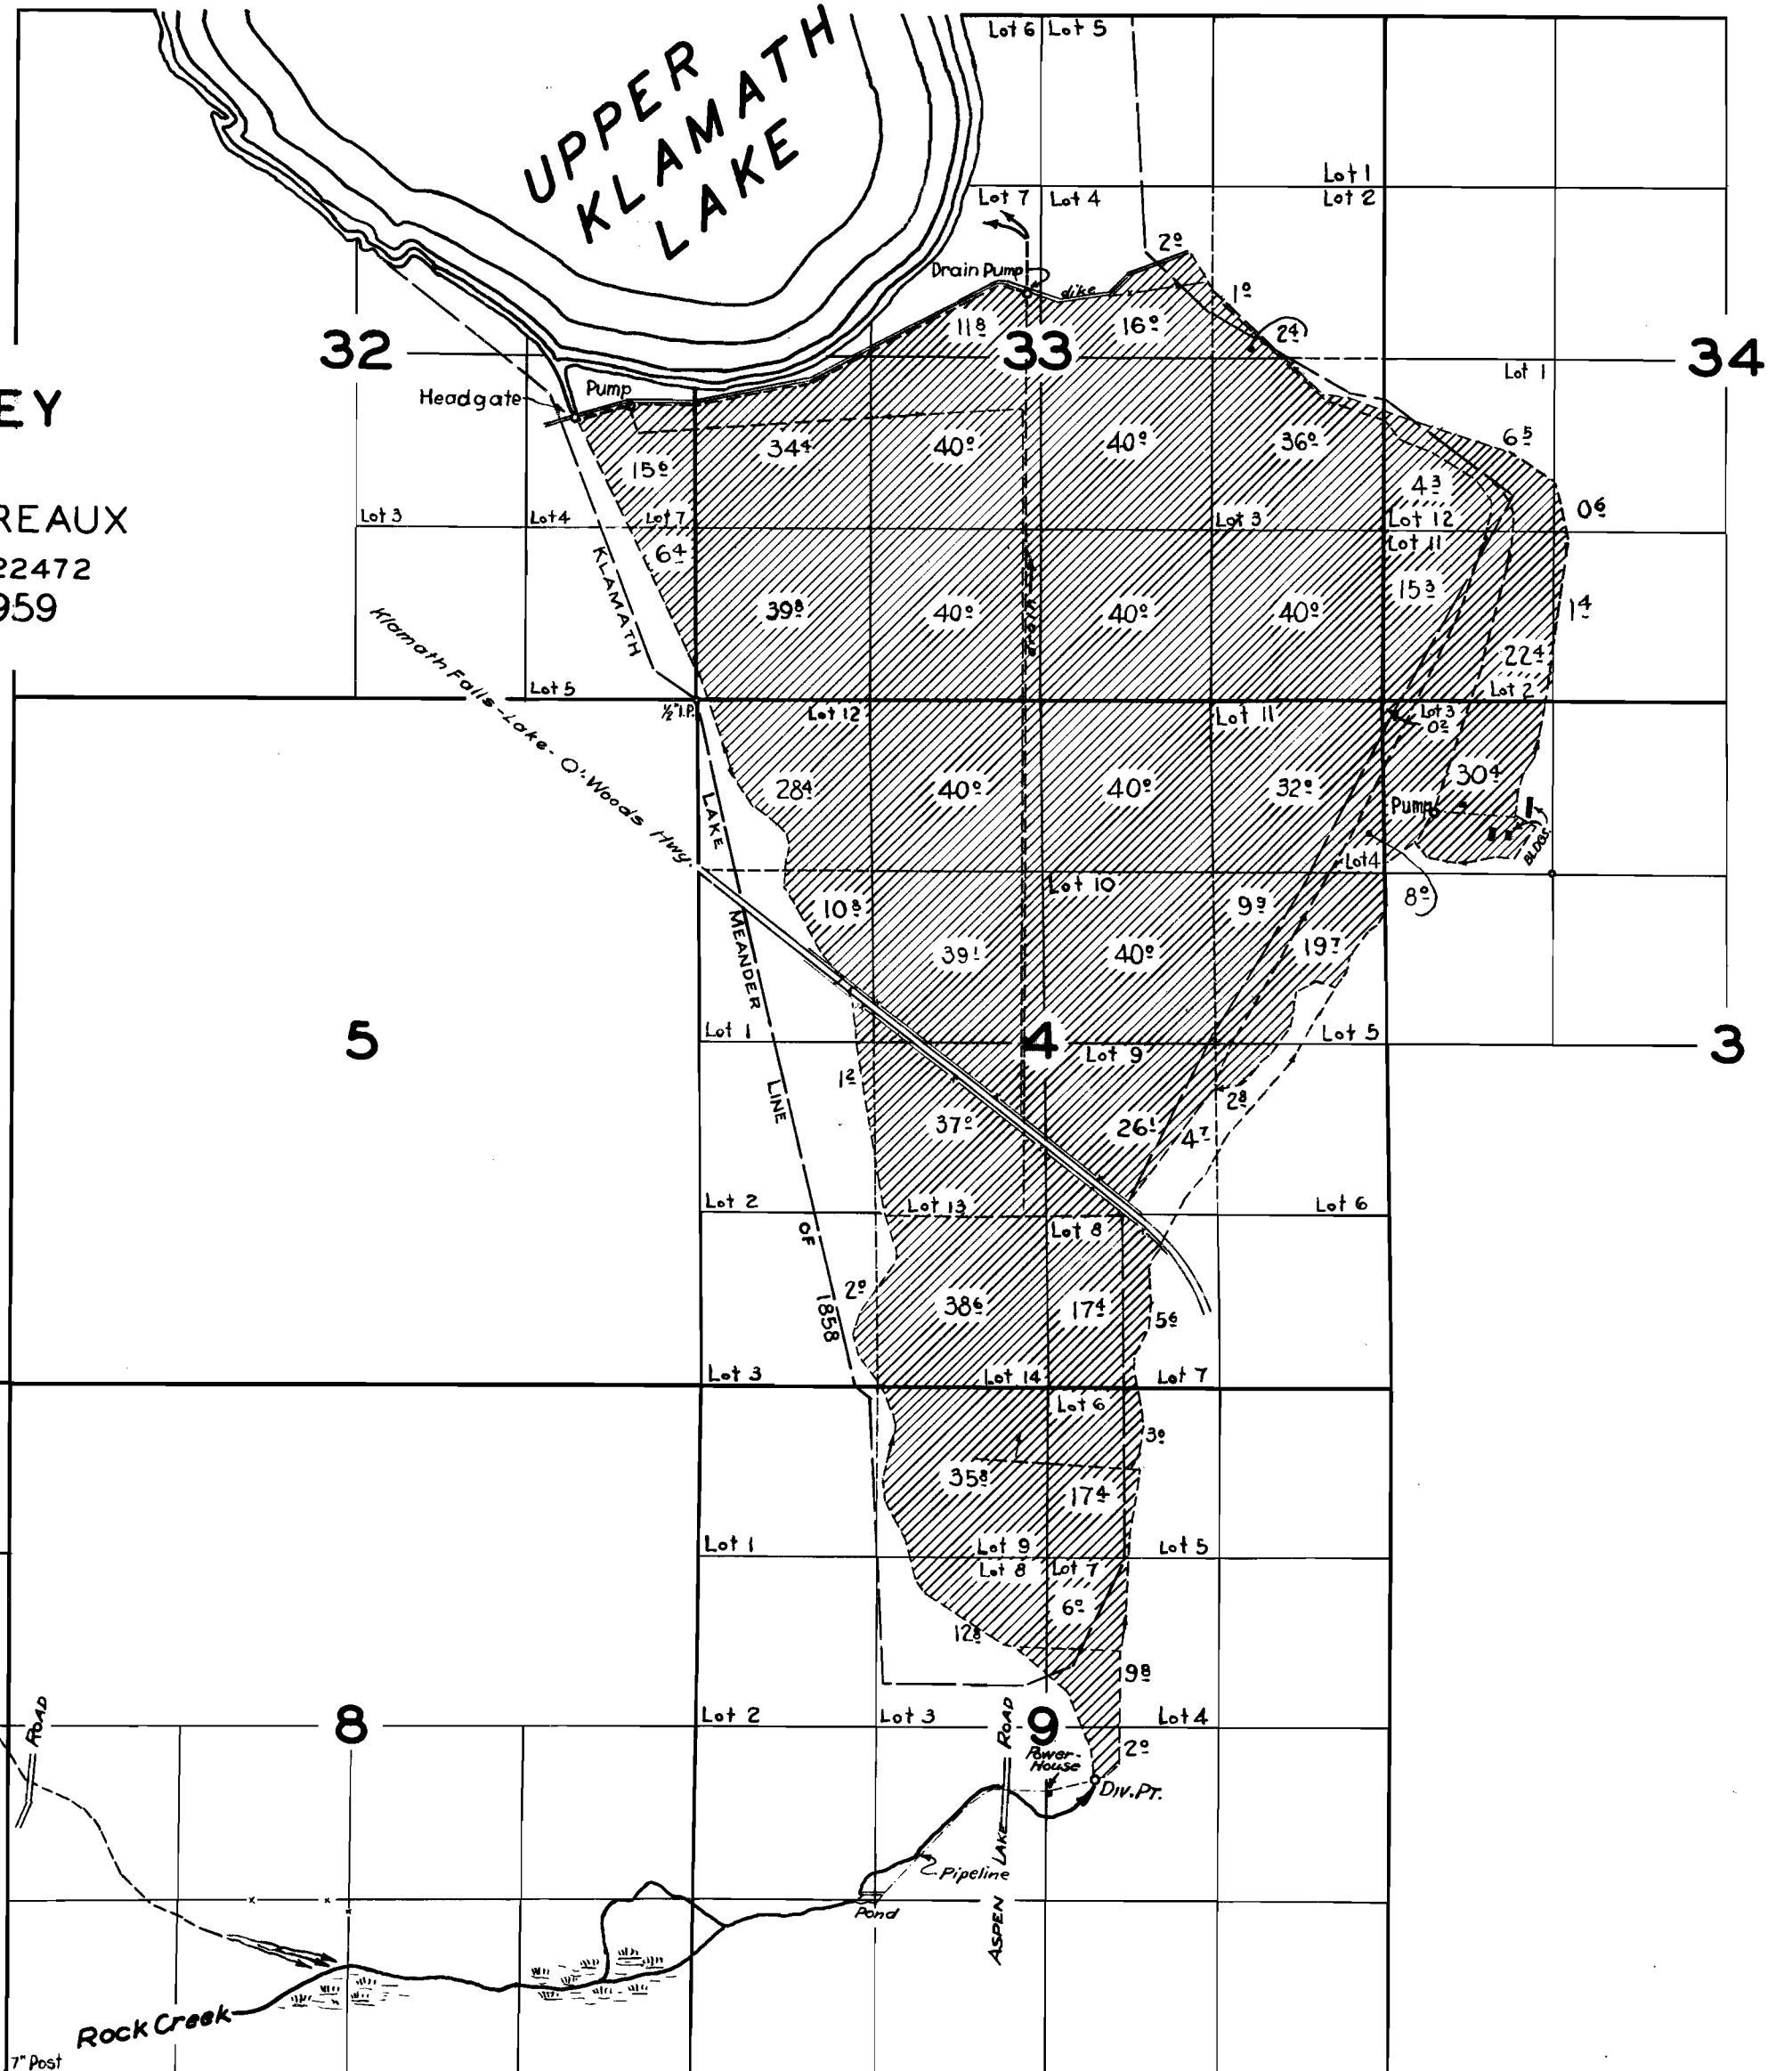

T. 37 S. R. 7 E. W. M.