


T.31 S.R.42E.W.M.

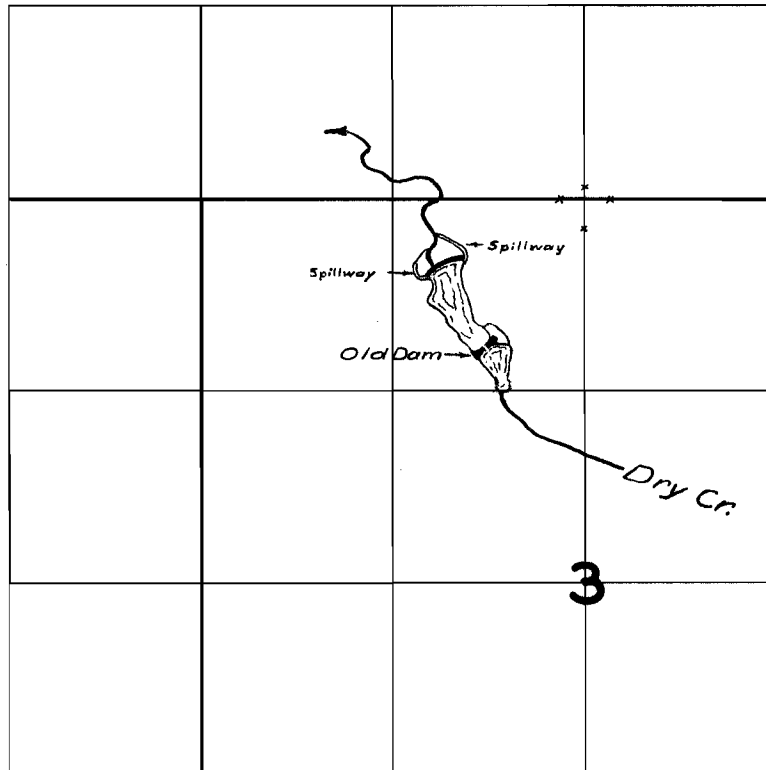

FINAL PROOF SURVEY

UNDER

Application No. 28192 Permit No. 22485
R-28414 R-1537

IN NAME OF

RUBY LYNDE

Surveyed 25 Sept. 19.59, by M. Bish