


T.31 S.R.42E.W.M.

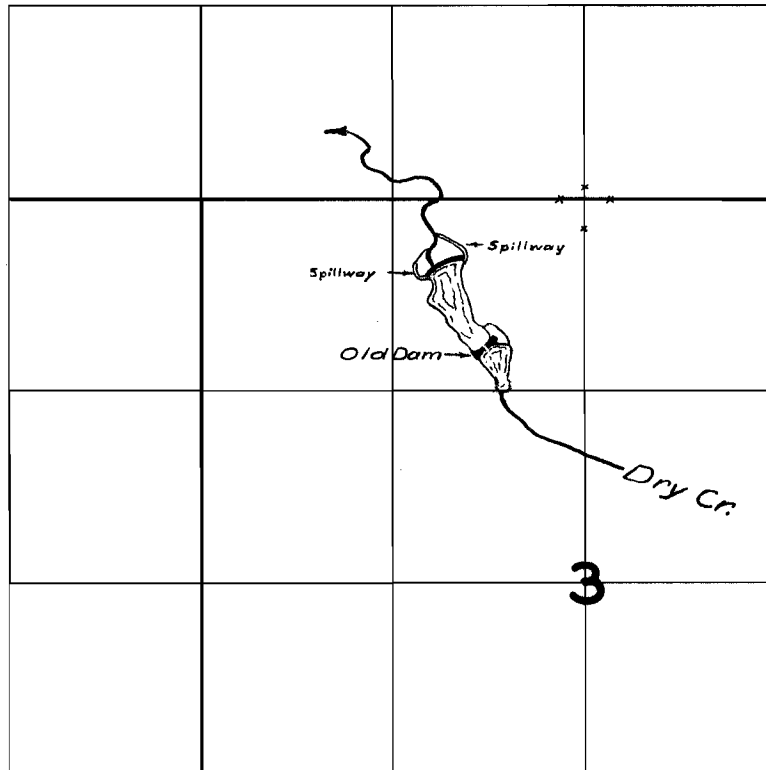

FINAL PROOF SURVEY

UNDER

Application No. 28192 R-28414 Permit No. 22485 R-1537

IN NAME OF

RUBY LYNDE

Surveyed 25 Sept. 19.59, by M. Bish