


T. 7N. R. 10W. W.M.

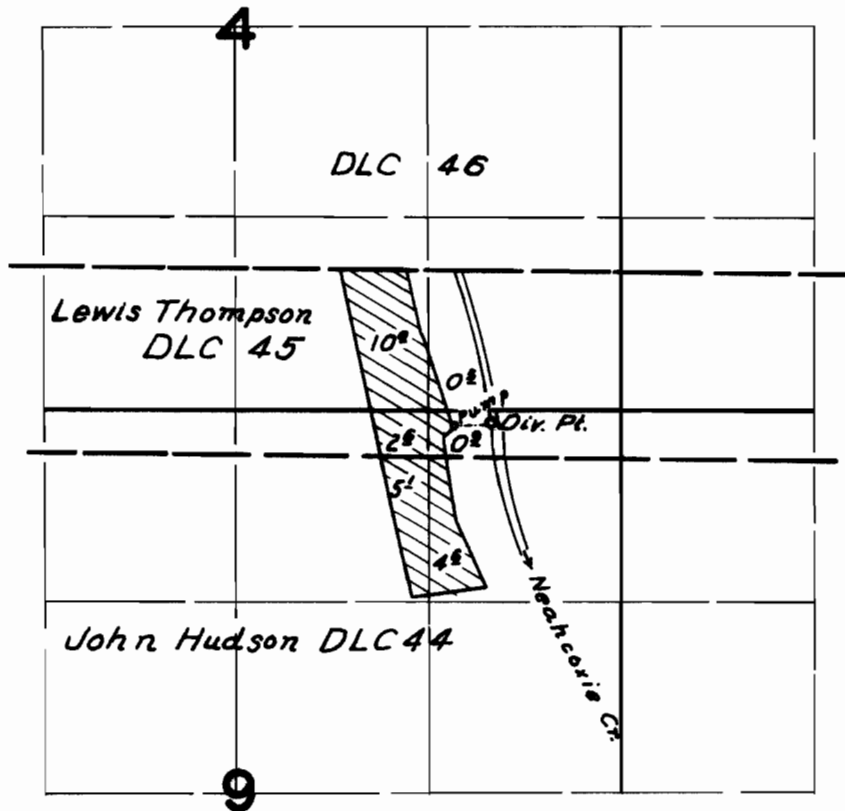

FINAL PROOF SURVEY
UNDER

Application No. 29452 Permit No. 23181
IN NAME OF

R. D. Lamb

Surveyed July 3, 1959, by C.O. Bartels