


2786  
27452

# T.38S.R.11 $\frac{1}{2}$ & 11E.W.M.

Bucke Crk; Yonna Valley

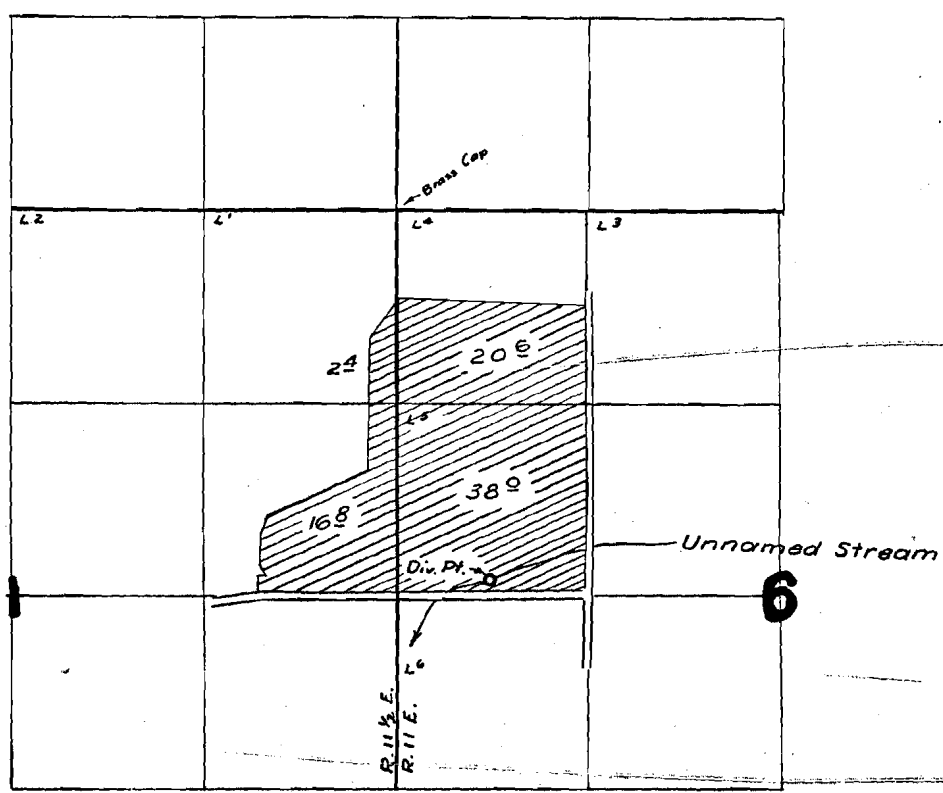

## FINAL PROOF SURVEY

UNDER

Application No. 29463 Permit No. 23186

IN NAME OF

JOSEPH M. COLAHAN, J. D. COLAHAN & GERTRUDE B. COLAHAN

Surveyed 12 Oct. 1959, by M. Bish