


T.8 S.R.3W.W.M.

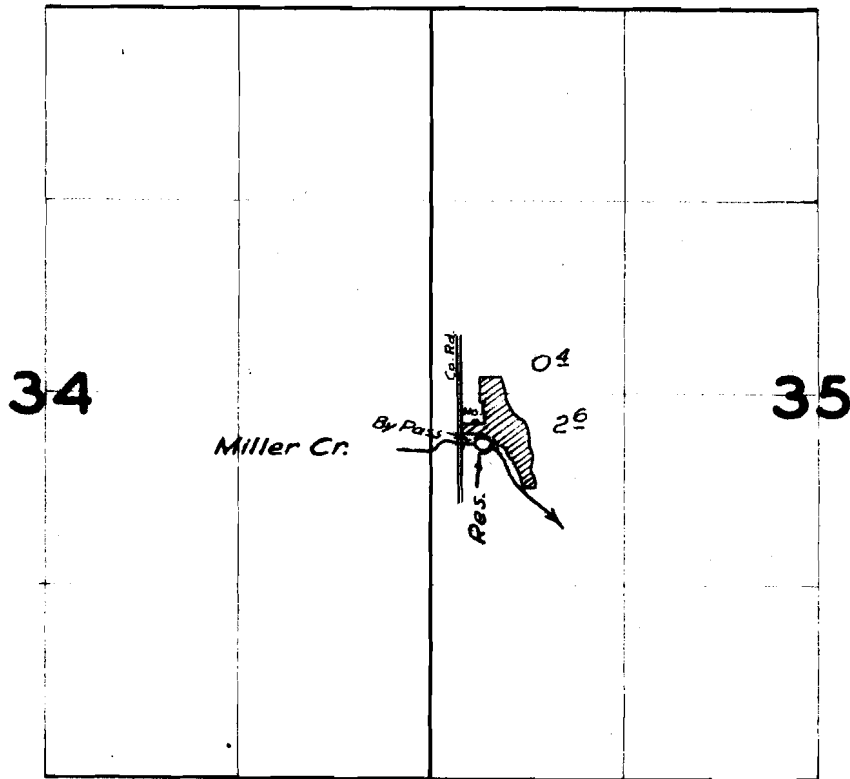

FINAL PROOF SURVEY
UNDER

Application No. 29510 R-29509 Permit No. 23204 R-1675
IN NAME OF

RUSSELL W. LANGFORD

Surveyed 11 June 1959, by Tm. Bish