


T. 1 S. R. 9 W. W. M.

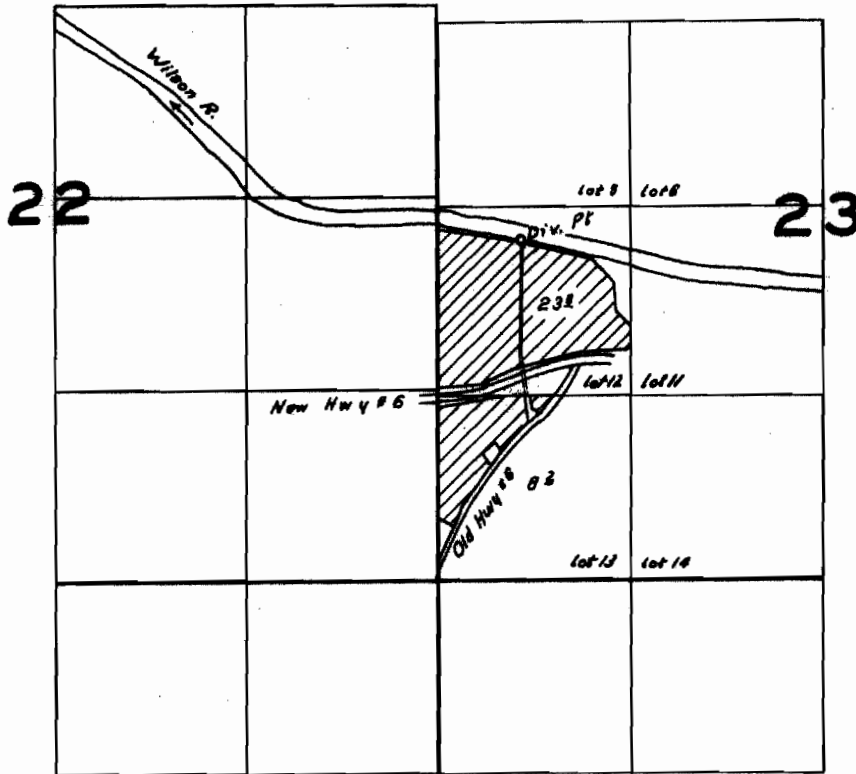

FINAL PROOF SURVEY
UNDER

Application No. 29698 Permit No. 23383
IN NAME OF

Aaron E. Dumbeck

Surveyed April 16 1958, by R. H. Jackson