


T.13 S.R.6 W.W.M.

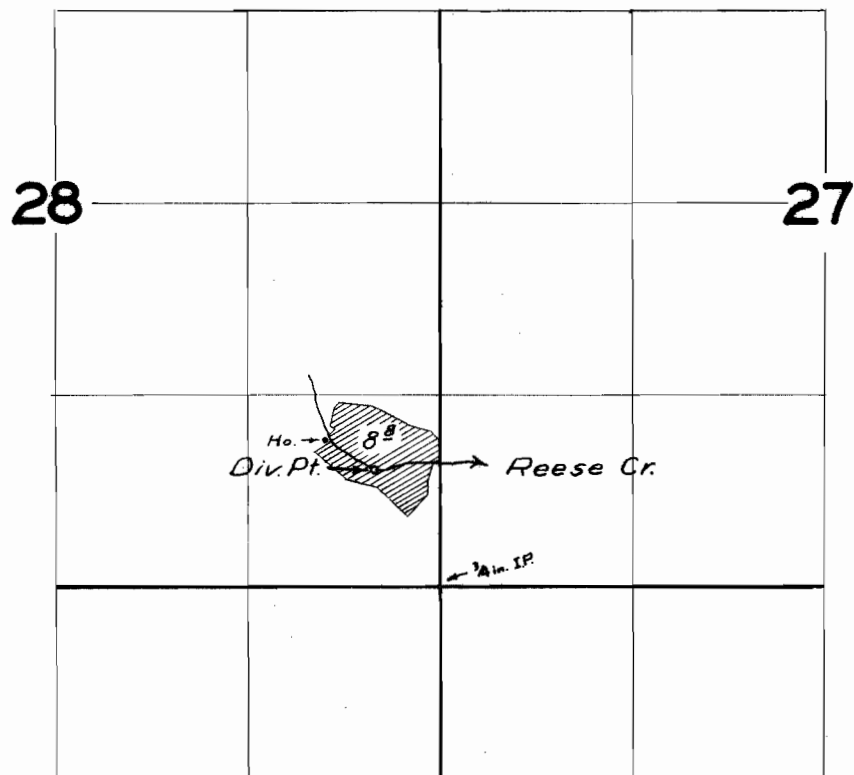

FINAL PROOF SURVEY
UNDER

Application No. 29279 Permit No. 23020
IN NAME OF

HAROLD A. & LILLIAN WALRATH

Surveyed 10 Mar. 1959, by Tom B. Bish