


T. 4 S. R. 39 E. W. M.

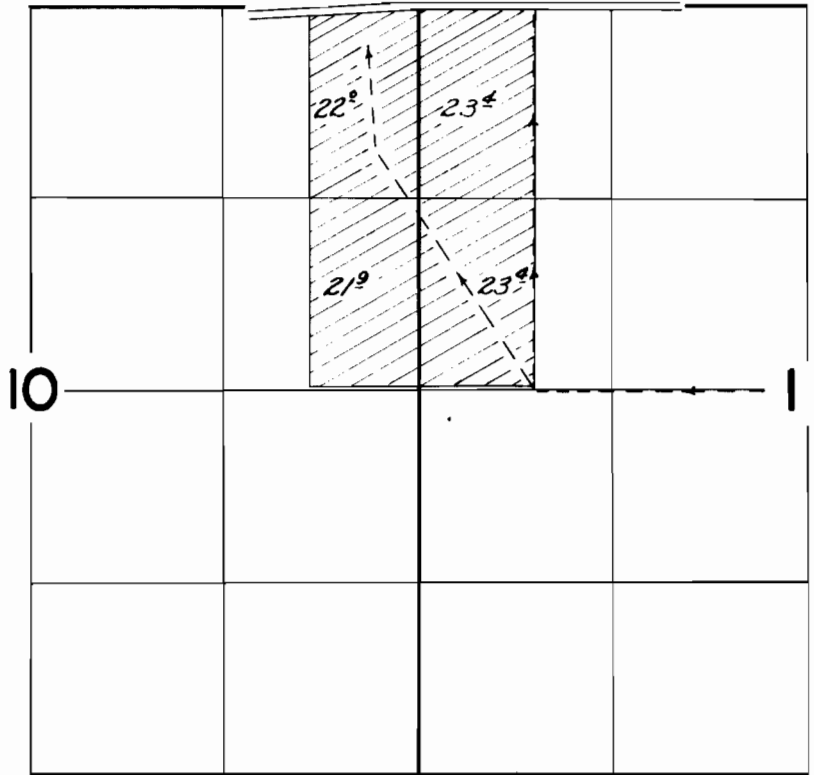

Note: Div. Point is located in
the SE 1/4 SE 1/4 of Sec. 13

FINAL PROOF SURVEY

UNDER

Application No. 27257...Permit No. 23424...

IN NAME OF

.....*Joan Bouvy Stuart*.....

Surveyed *Aug. 14*, 1959, by *C. O. Bartels*.