


T.30 S.R.46 E.W.M.

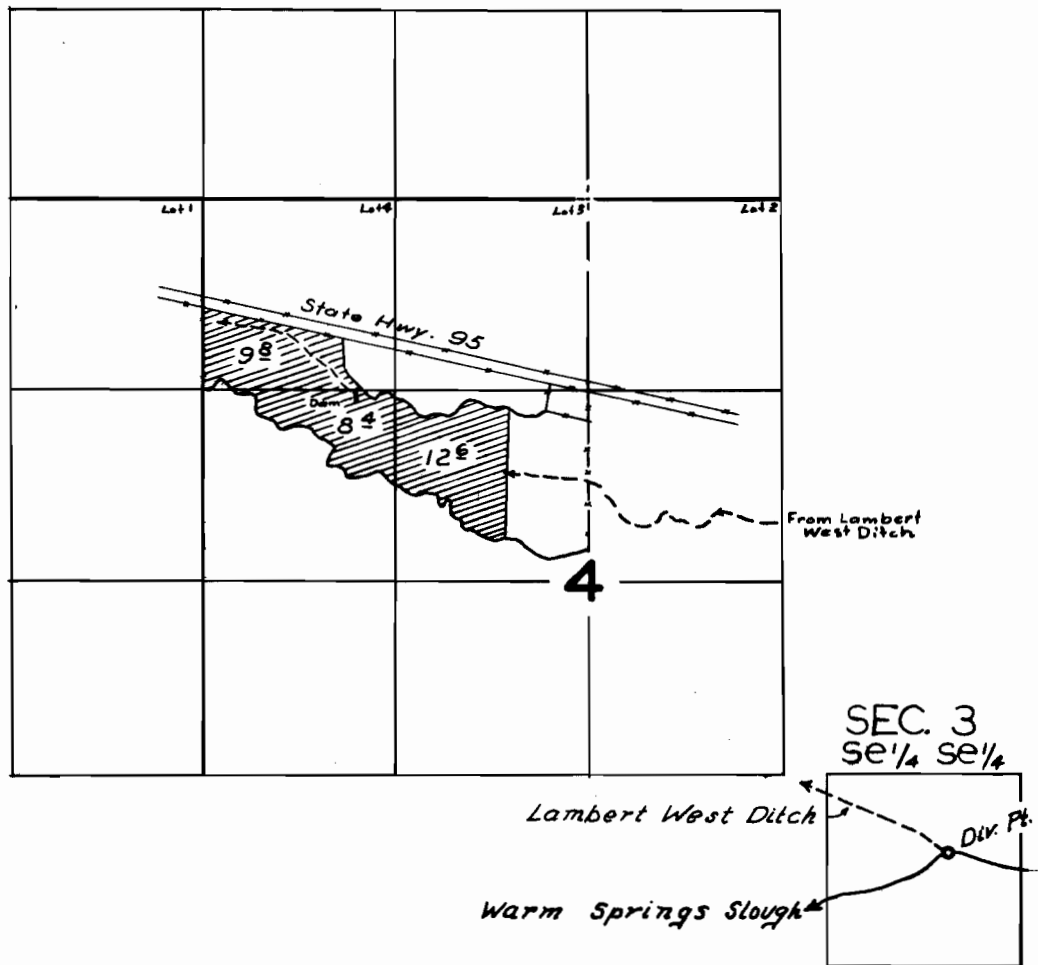

FINAL PROOF SURVEY
UNDER

Application No. 29886 Permit No. 23535
IN NAME OF

MARION F. WROTEN

Surveyed Sept. 24 1959, by W. Bieh