


T. 7S. R. 1W. W.M.

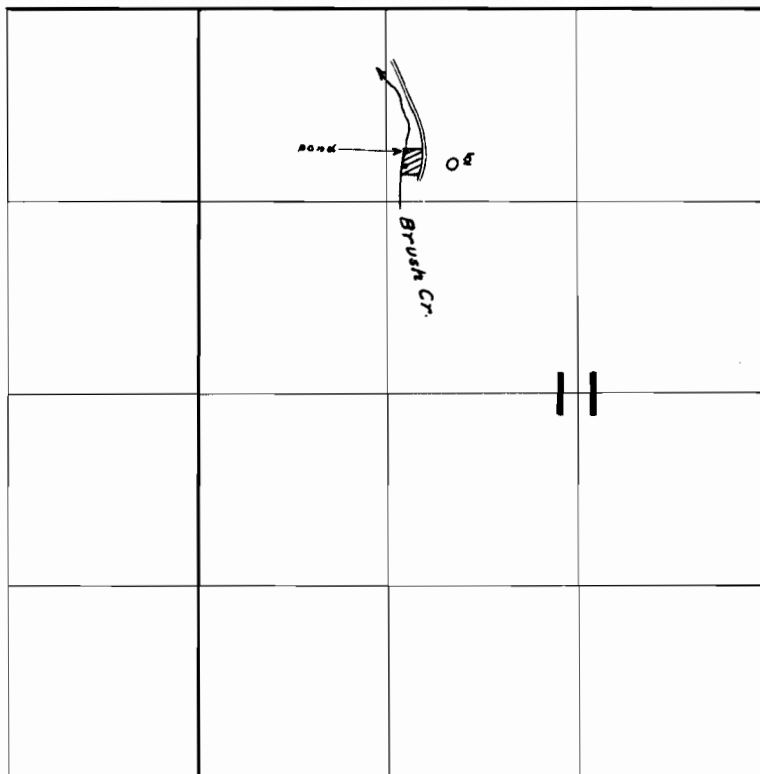

FINAL PROOF SURVEY
UNDER

Application No. 30056 ... Permit No 23695
IN NAME OF

..... *Patrica A. Carson*

Surveyed *June 11, 1959*, by *R.H. Jackson*.....