


T.18-19S. R.6W.W.M.

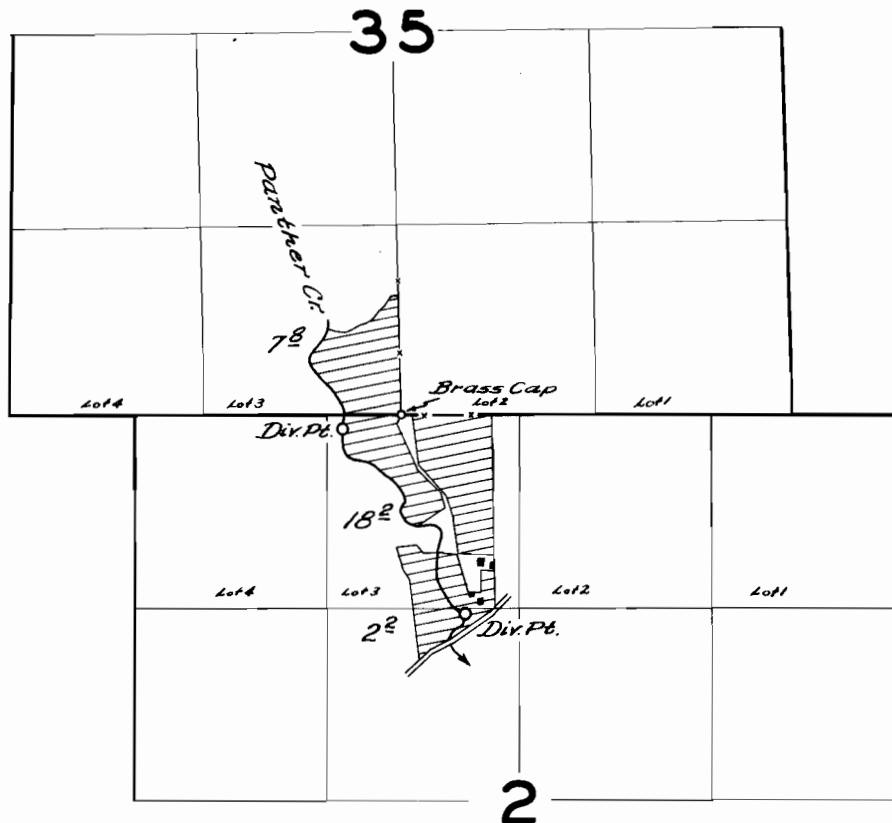

FINAL PROOF SURVEY
UNDER

Application No. 30239 Permit No. 23836
IN NAME OF

Bennie S. Marsh

Surveyed April 8, 1959, by C.D. Baile