


T.36S. R.5W.W.M.

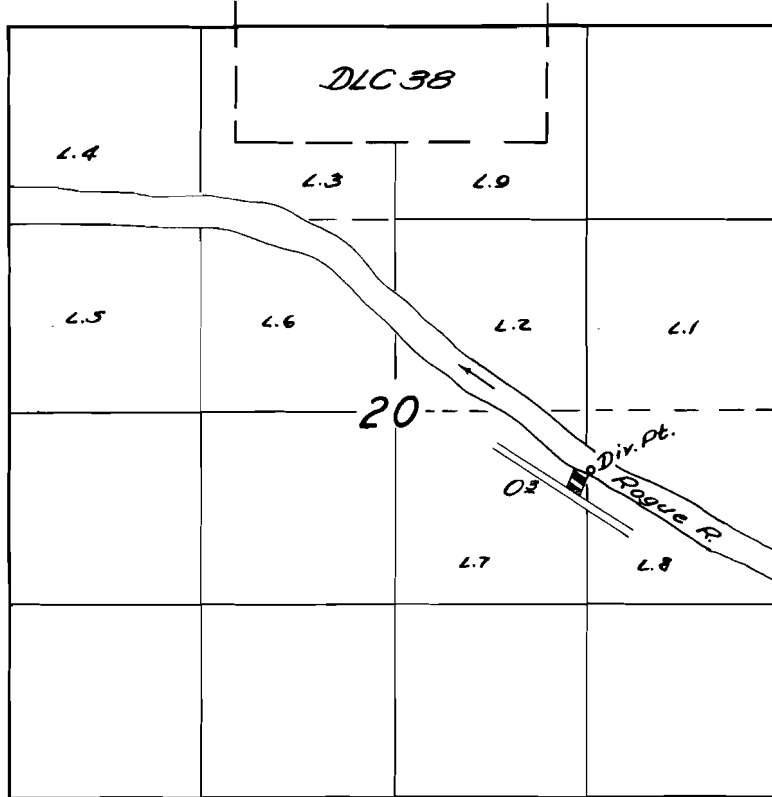

# FINAL PROOF SURVEY

UNDER

Application No. 30496 Permit No. 23908

IN NAME OF

Mildred E. Wilbur

Surveyed July 14 1959, by C. O. Bartels